


# STATE OF VERMONT AGENCY OF TRANSPORTATION

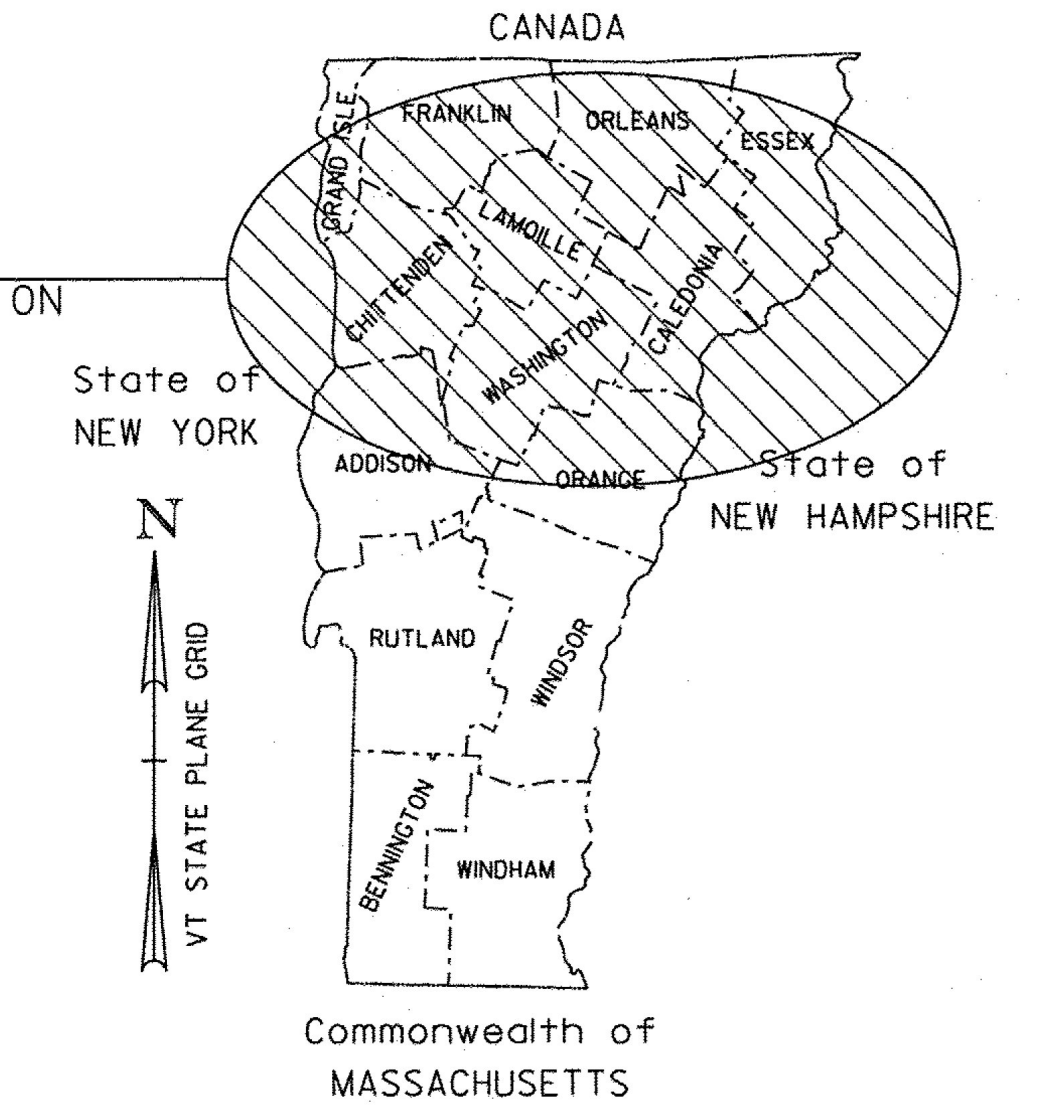

PROJECT LOCATION  
STATEWIDE NORTH REGION  
STP HRRR (22)



**Record Plans**  
Contractor: F.R. LAFAYETTE, INC.  
Resident Engineer: LOGAN PERRON  
Construction Began: OCTOBER 18, 2017  
Construction Complete: MAY 30, 2019  
Record Plans By: LOGAN PERRON & JESSE IVES

I hereby certify that all construction required by this set of drawings has been accomplished as indicated herein.

BY: E-SIGNED by Logan Perron  
on 2020-01-16 19:14:21 GMT Resident Engineer

Date: January 16, 2020

NOTE: Any further information concerning final quantities, amounts or other details relative to this project may be found at Central Files in the electronic archives.

## PROPOSED IMPROVEMENT TOWNS OF BARRE, BARTON, BRAINTREE, BURLINGTON, CABOT, DANVILLE, FAIRFIELD, FLETCHER, GEORGIA, HINESBURG, HYDE PARK, JAY, JERICHO, MORRISTOWN, ORANGE, PANTON, RICHFORD, ROXBURY, SHELBURNE, SOUTH HERO, ST. GEORGE, ST. JOHNSBURY, UNDERHILL, WARREN AND WOLCOTT COUNTIES OF ADDISON, CALEDONIA, CHITTENDEN, FRANKLIN, GRAND ISLE, LAMOILLE, ORANGE, ORLEANS AND WASHINGTON


SITE 1 BARRE (VT ROUTE 63):	MP 0.971 - 1.029 = 0.058 MILES	SITE 15 JERICHO TH-5 (RIVER RD):	MP 0.000 - 0.445 = 0.445 MILES
SITE 2 BARTON TH-3 (MAPLE HILL RD):	MP 0.000 - 3.450 = 3.450 MILES	SITE 16 MORRISTOWN TH-6 (RANDOLPH RD):	MP 0.000 - 6.009 = 6.009 MILES
SITE 3 BRAINTREE TH-6 (HOCKMAN HILL RD):	MP 0.000 - 0.509 = 0.509 MILES	SITE 17 ORANGE TH-1 (RESERVOIR RD):	MP 0.000 - 4.850 = 4.850 MILES
SITE 4 BRAINTREE (PETH RD):	MP 0.000 - 1.482 = 1.482 MILES	SITE 18 PANTON TH-1 (JERSEY ST):	MP 0.000 - 1.222 = 1.222 MILES
SITE 5 BURLINGTON (VT ROUTE 127):	MP 2.980 - 3.621 = 0.641 MILES	SITE 19 PANTON TH-1 (PANTON RD):	MP 0.000 - 3.694 = 3.694 MILES
SITE 6 CABOT TH-1 (VT ROUTE 215):	MP 0.000 - 6.765 = 6.765 MILES	SITE 20 RICHFORD TH-2 (S RICHFORD RD):	MP 0.000 - 5.280 = 5.280 MILES
SITE 7 DANVILLE TH-3 (PEACHAM RD):	MP 0.000 - 3.178 = 3.178 MILES	SITE 21 ROXBURY TH-1 (WARREN MTN RD):	MP 0.000 - 2.975 = 2.975 MILES
SITE 8 FAIRFIELD TH-1 (NORTH RD):	MP 0.000 - 0.345	SITE 22 SHELBURNE TH-5 (DORSET ST):	MP 0.000 - 1.283 = 1.283 MILES
TH-2 (CHESTER A ARTHUR RD):	MP 0.000 - 2.076 = 2.421 MILES	SITE 23 SOUTH HERO TH-13 (W SHORE RD):	MP 0.000 - 5.557 = 5.557 MILES
SITE 9 FLETCHER TH-2 (FAIRFIELD RD):	MP 0.000 - 6.225 = 6.225 MILES	SITE 24 ST. GEORGE TH-2 (S BROWNELL RD):	MP 0.000 - 0.058 = 0.058 MILES
SITE 10 GEORGIA TH-31 (SKUNK HILL RD):	MP 0.000 - 2.926 = 2.926 MILES	SITE 25 ST. JOHNSBURY TH-8 (SEVERANCE HILL RD):	MP 0.000 - 3.525 = 3.525 MILES
SITE 11 HINESBURG TH-9 (NORTH RD):	MP 0.000 - 2.321 = 2.321 MILES	SITE 26 ST. JOHNSBURY PIERCE RD	MP 0.000 - 1.130
SITE 12 HYDE PARK TH-1 (CENTERVILLE RD):	MP 0.000 - 3.800 = 3.800 MILES	TH-14 (NEW BOSTON RD)	MP 0.000 - 0.864 = 1.994 MILES
SITE 13 HYDE PARK TH-3 (N HYDE PARK RD):	MP 0.000 - 4.445 = 4.445 MILES	SITE 27 UNDERHILL TH-1 (RIVER RD):	MP 0.000 - 0.511 = 0.511 MILES
SITE 14 JAY TH-1 (CROSS RD)	MP 0.000 - 0.380	SITE 28 WARREN TH-5 (SUGARBUSH ACCESS RD):	MP 0.000 - 2.880 = 2.880 MILES
TH-4 (REVOIR FLAT RD)	MP 0.000 - 0.509 = 0.889 MILES	SITE 29 WILLISTON TH-2 (S BROWNELL RD):	MP 0.058 - 2.414 = 2.356 MILES
		SITE 30 WOLCOTT TH-1 (N WOLCOTT RD):	MP 0.000 - 5.232 = 5.232 MILES

LENGTH OF PROJECT = 86.981 MILES

CONSTRUCTION IS TO BE CARRIED ON IN ACCORDANCE WITH THESE PLANS AND THE STANDARD SPECIFICATIONS FOR CONSTRUCTION DATED 2011, AS APPROVED BY THE FEDERAL HIGHWAY ADMINISTRATION ON JULY 20, 2011 FOR USE ON THIS PROJECT, INCLUDING ALL SUBSEQUENT REVISIONS AND SUCH REVISED SPECIFICATIONS AND SPECIAL PROVISIONS AS ARE INCORPORATED IN THESE PLANS.

WORK TO BE PERFORMED UNDER THIS PROJECT INCLUDES THE REMOVAL OF EXISTING SIGNS AND POSTS AND THE INSTALLATION OF NEW SIGNS AND SIGN POSTS, GUARDRAIL, PAVEMENT MARKINGS AND OTHER HIGHWAY RELATED ITEMS.

QUALITY ASSURANCE PROGRAM : LEVEL 3	
SURVEYED BY : N/A	
SURVEYED DATE : N/A	
DATUM	
VERTICAL	N/A
HORIZONTAL	N/A

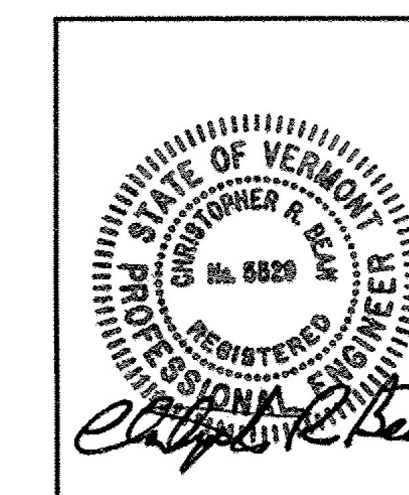

DIRECTOR OF PROJECT DELIVERY	
APPROVED <i>[Signature]</i>	DATE 5/17/2017
PROJECT MANAGER : PATRICIA COBURN, P.E.	
PROJECT NAME : STATEWIDE NORTH REGION	
PROJECT NUMBER : STP HRRR (22)	
SHEET 1 OF 255 SHEETS	