


PAVEMENT MARKING LINE DETAIL

ITEM 646.404 - DURABLE 4 INCH WHITE LINE, POLYUREA

TOWN	LOCATION	MILE MARKER	DESCRIPTION	TYPE	LENGTH (FEET)	QUANTITY (FEET)
JERICO	TH-5 RIVER ROAD	0.000-0.038	RIVER RD LANE LINE (NORTH SIDE)	SWL	220	220
JERICO	TH-5 RIVER ROAD	0.000-0.038	RIVER RD LANE LINE (SOUTH SIDE)	SWL	200	200
JERICO	TH-5 RIVER ROAD	0.000-0.006	RIVER RD (TURNING LANE DIVIDER)	SWL	30	28 30
CABOT	TH-1 VT ROUTE 215	3.435	S WALDEN RD (PAINTED ISLAND) (SEE SHEET 10)	SWL	114	126 114
					SUBTOTAL	564
					ROUNDING	36
					TOTAL	600 574 LF

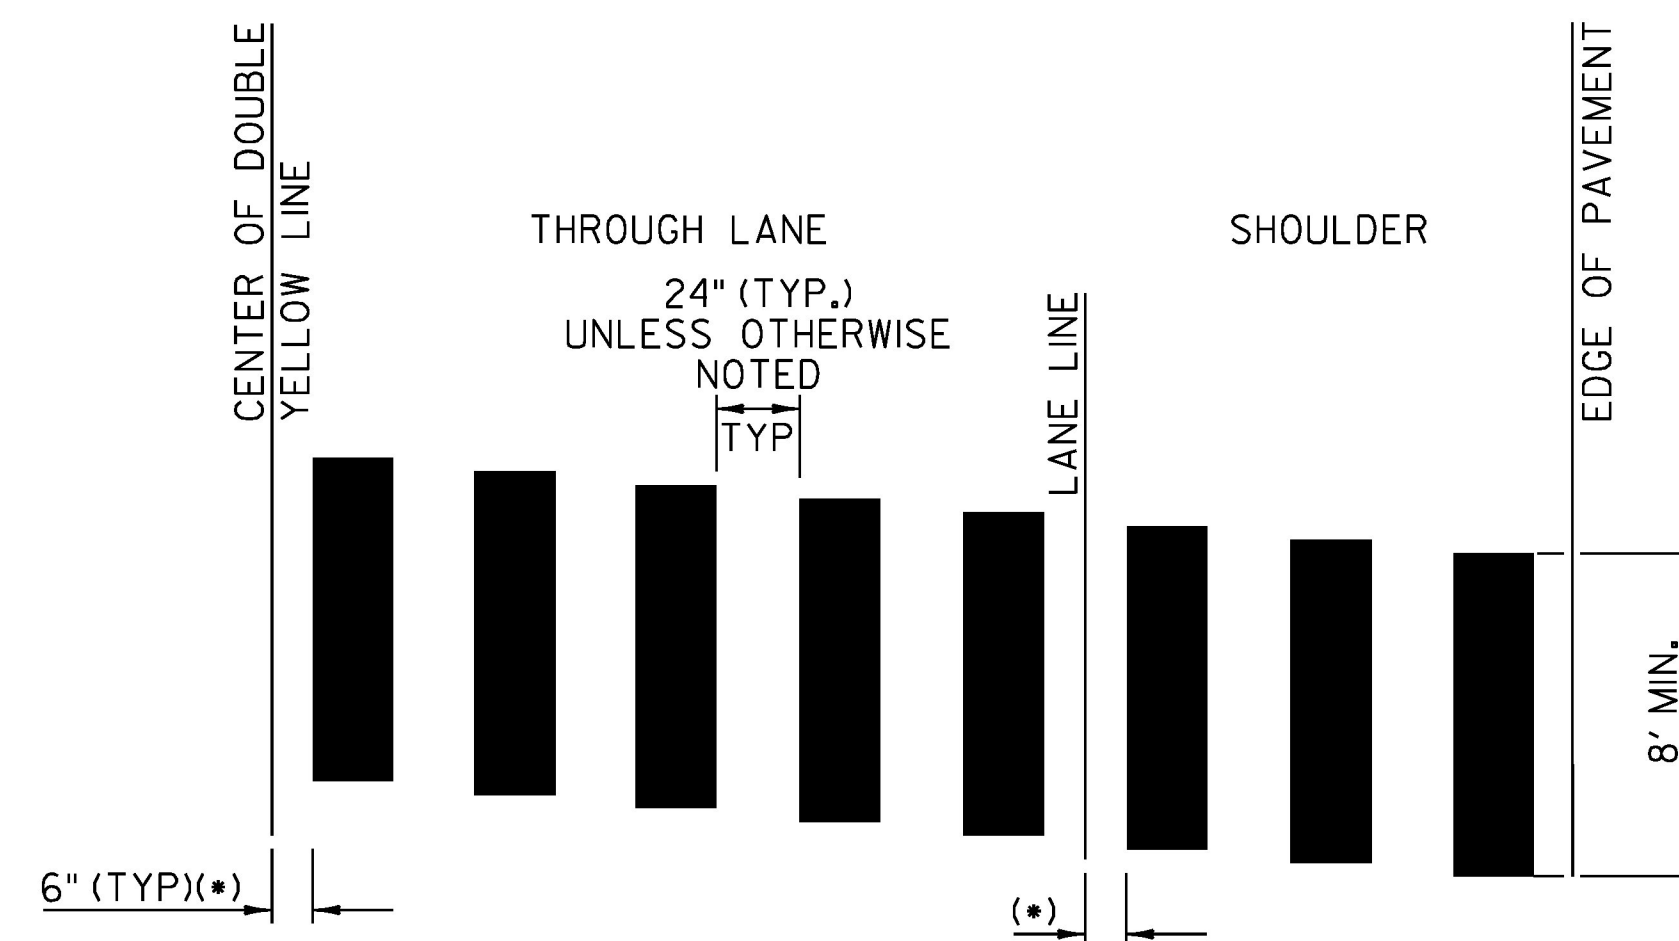

CROSSWALK DETAIL NOTES:

1. THIS DETAIL IS CONFIGURED FOR AN 11 FOOT LANE.
2. MARK LIGHT STRING LINE ON PAVEMENT ACROSS ROADWAY (CURB TO CURB).
3. ESTABLISH THE CENTER LINE OF THE ROADWAY (DOUBLE YELLOW LINE OR LANE LINE).
4. BLOCKS ARE PARALLEL TO THE CENTERLINE (DOUBLE YELLOW LINE OR LANE LINE) (OFFSET BLOCKS VERTICALLY TO ACHIEVE REQUIRED SKEW).
5. ALWAYS START MEASURING FROM THE CENTERLINE OR LANE LINE RIGHT, WITH THE FLOW OF TRAFFIC.
6. PAINTED BLOCKS ARE 24 INCHES (TYPICAL).
- (*)7. ADJUST SPACING TO 12 INCHES FOR A 12 FOOT LANE.

BLOCK PATTERN CROSSWALK DETAIL

ITEM 646.504 - DURABLE CROSSWALK MARKING, POLYUREA

TOWN	DESCRIPTION	MILE MARKER	LENGTH (FT)
CABOT	CABOT VISITORS CENTER	2.888	25
CABOT	TOWN OFFICE	3.087	37 41
CABOT	HIGH SCHOOL	3.207	30
CABOT	GYM RD	3.286	30
JERICO	CROSSING PARK ST ON NORTH SIDE OF INTERSECTION WITH TH-5	0.445	84 88
SUBTOTAL			214
ROUNDING			1
TOTAL			215 206 LF

ITEM 646.414 - DURABLE 4 INCH YELLOW LINE, POLYUREA

TOWN	LOCATION	MILE MARKER	DESCRIPTION	TYPE	LENGTH (FEET)	QUANTITY (FEET)
CABOT	TH-1 VT ROUTE 215	3.070	WHITTIER HILL RD CENTERLINE	DYL	50	150 100
CABOT	TH-1 VT ROUTE 215	3.137	DANVILLE HILL RD CENTERLINE	DYL	50	100
JERICO	TH-5 RIVER ROAD	0.000-0.038	RIVER RD CENTERLINE	DYL	200	400
PANTON	TH-1 JERSEY STREET	0.681-0.719	JERSEY ST CENTERLINE	DYL	200	400
WARREN	TH-5 SUGARBUSH ACCESS	0.928	GERMAN FLATS RD CENTERLINE	DYL	200	400
					SUBTOTAL	1400
					ROUNDING	50
					TOTAL	1450 950 LF

DESIGN REQUEST

PAINTED UNDER MARK CONTRACT

DESIGN REQUEST

ITEM 646.484 - DURABLE 24 INCH STOP BAR, POLYUREA

TOWN	DESCRIPTION	MILE MARKER	STOP BAR LENGTH (FT)
CABOT	TH-1 AND WHITTIER HILL RD INTERSECTION	3.070	30
CABOT	TH-1 AND DANVILLE HILL RD INTERSECTION	3.140	30
CABOT	TH-1 AND COMMON RD INTERSECTION	3.207	30
CABOT	TH-1 AND GYM RD INTERSECTION	3.283	16
HYDE PARK	TH-3 AND LONGMORE HILL RD INTERSECTION	0.696	35
HYDE PARK	TH-3 AND JONES RD	3.446	30
JERICO	RIGHT TURN LANE, TH-5, SB	0.000	13
JERICO	LEFT TURN LANE, TH-5, SB	0.000	13
MORRISTOWN	TH-6 AND MAIN ST INTERSECTION, NB	6.003	16
PANTON	TH-1 AND PEASE RD INTERSECTION, NB	0.095	16
PANTON	TH-1 AND BUTTON BAY RD INTERSECTION, SB	1.149	12
ST. GEORGE	S. BROWNELL RD. SB (SEE SHEET 10)	0.017	11
ST. GEORGE	S. BROWNELL RD. SB (SEE SHEET 10)	0.055	11
ST. GEORGE	S. BROWNELL RD. SB (SEE SHEET 10)	0.058	11
WARREN	SUGARBUSH ACCESS RD AND GERMAN FLATS RD INTERSECTION	0.928	20
WARREN	SUGARBUSH ACCESS RD, WB	2.880	18
SUBTOTAL			312
ROUNDING			13
TOTAL			325 383 LF

ITEM 646.444 - DURABLE 8 INCH WHITE LINE, POLYUREA

TOWN	LOCATION	MILE MARKER	DESCRIPTION	TYPE	LENGTH (FEET)	QUANTITY (FEET)
CABOT	TH-1 VT ROUTE 215	3.435	S WALDEN RD (PAINTED ISLAND) (SEE SHEET 10)	SWL	102	123 102
					SUBTOTAL	102
					ROUNDING	18
					TOTAL	120 123 LF

PROJECT NAME:	STATEWIDE NORTH REGION
PROJECT NUMBER:	STP HRRR(22)
FILE NAME: z14k100frm.dgn	PLOT DATE: 5/31/2017
PROJECT LEADER: K. RUTTER	DRAWN BY: R. SHEDD
DESIGNED BY: R. SHEDD	CHECKED BY: K. RUTTER
PAVEMENT MARKING DETAILS SHEET 1	SHEET 13 OF 255

NOT TO SCALE