

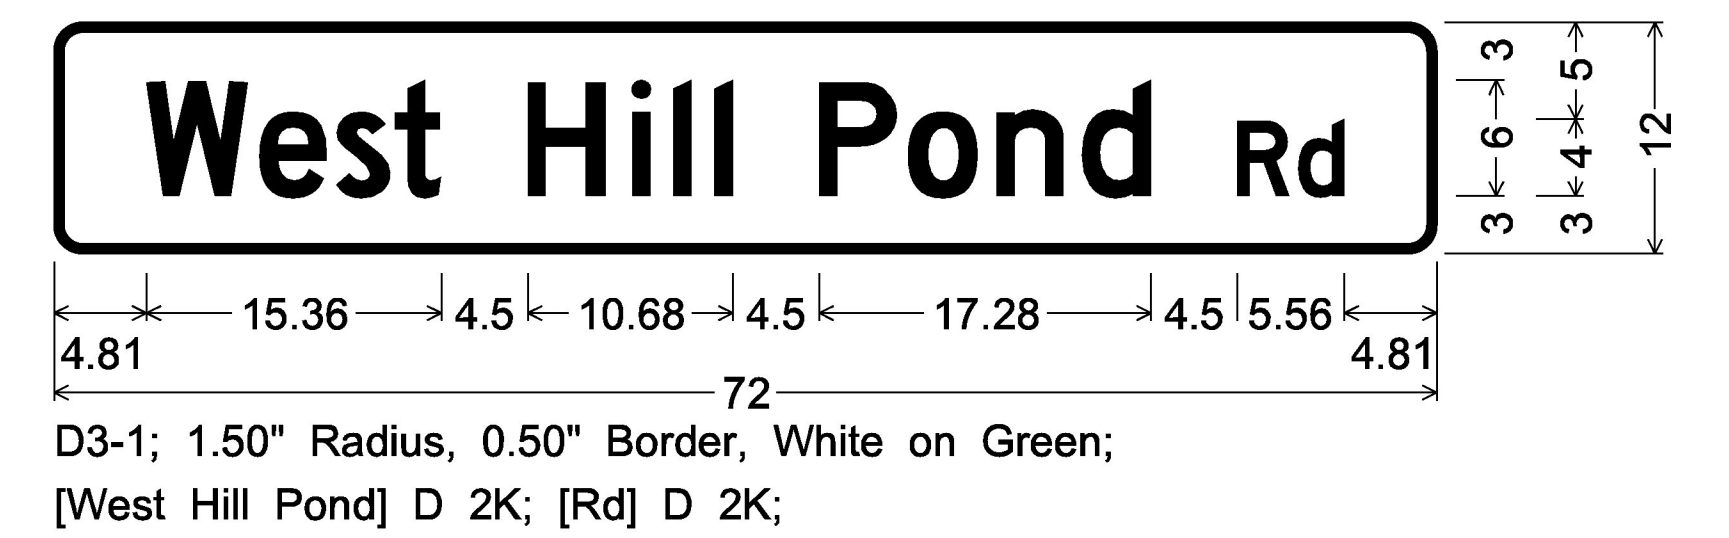
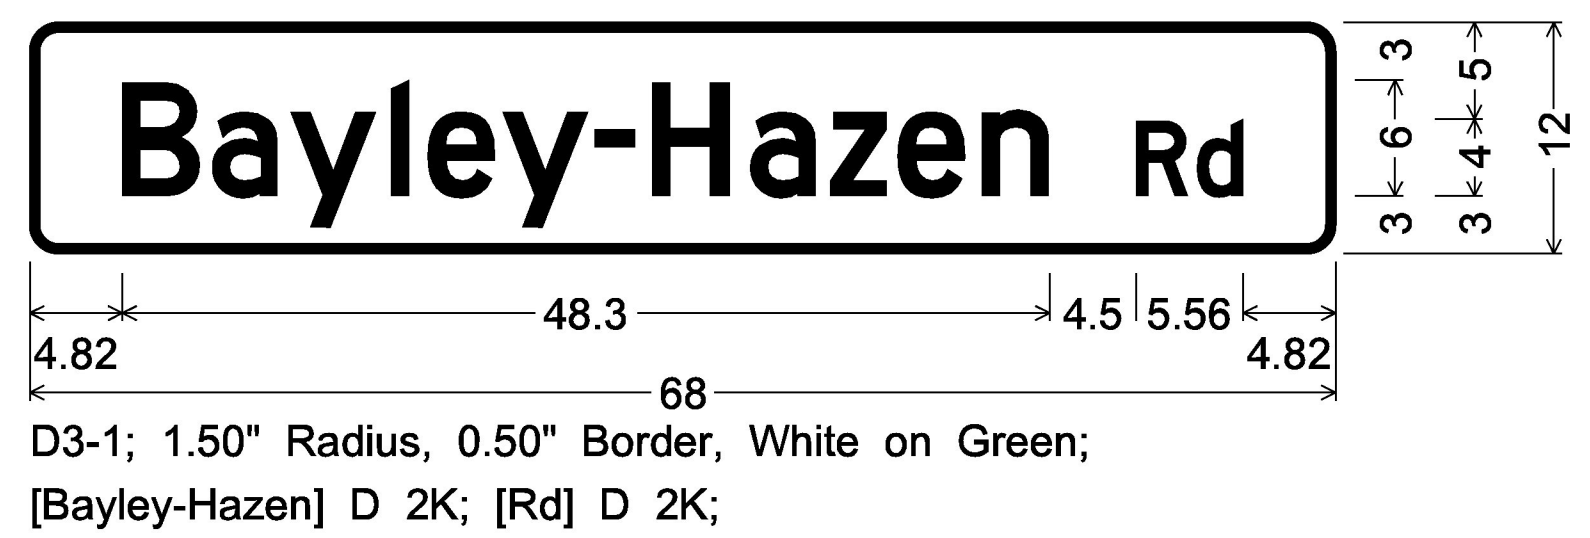
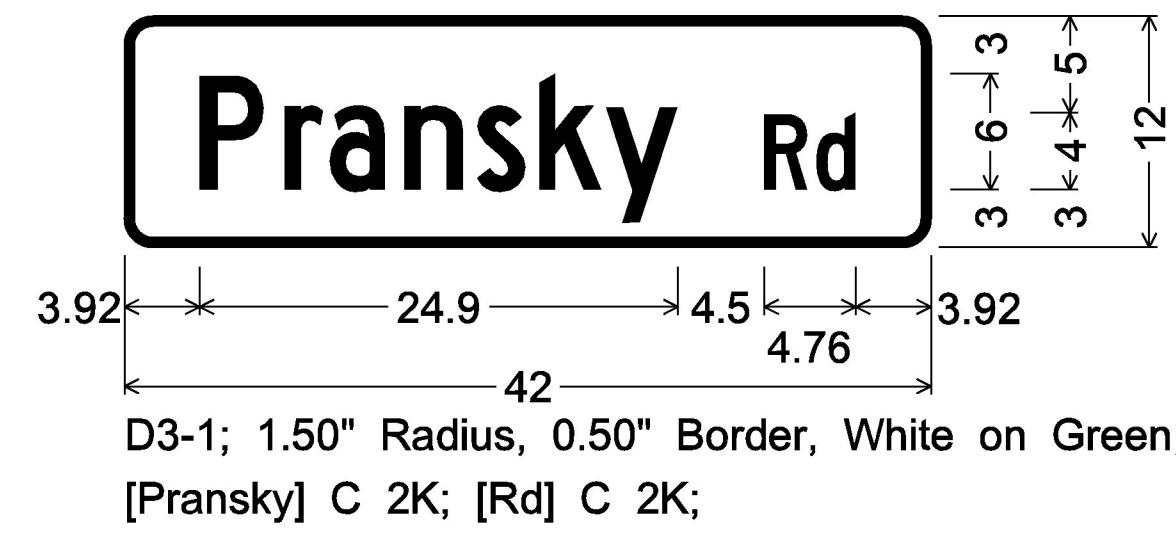


CABOT

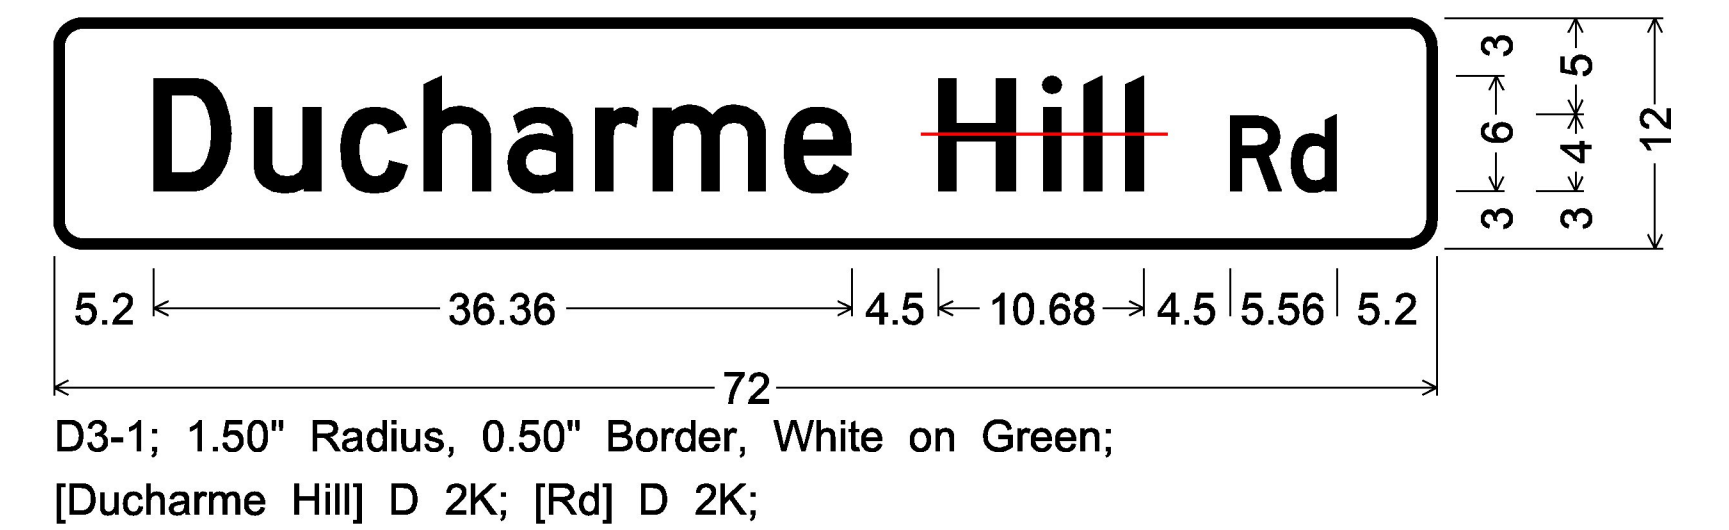

D3-1

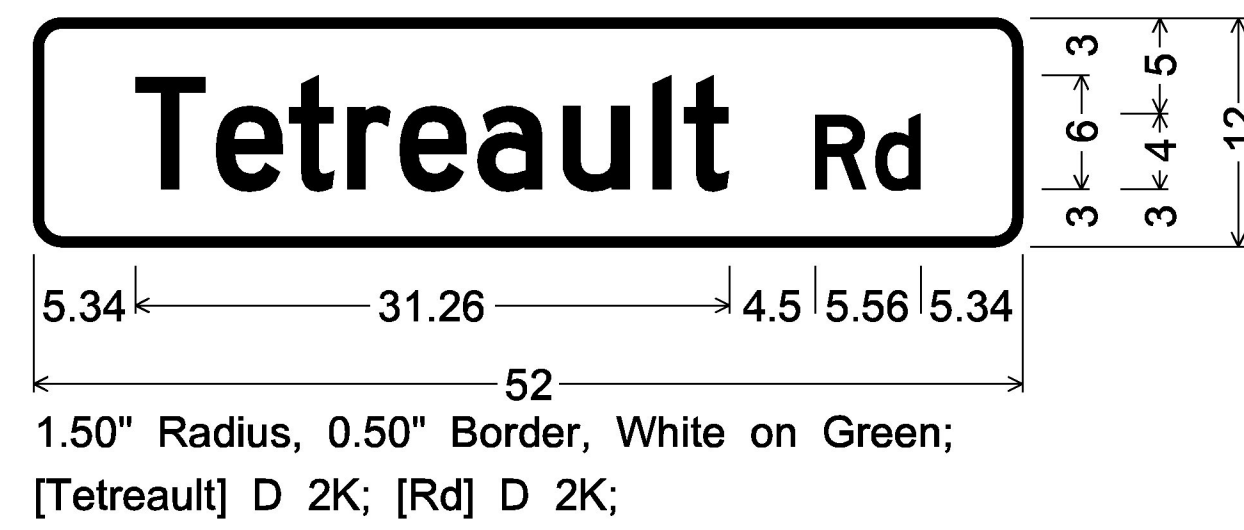

TOWN HIGHWAY SIGNS D3-1

TOWN HIGHWAY SIGNS SHALL BE DOUBLE SIDED SIGNS
AND SHALL BE INSTALLED WITH 12 INCH BRACKETS.

NOT TO SCALE

PROJECT NAME: STATEWIDE NORTH REGION	
PROJECT NUMBER: STP HRRR(22)	
FILE NAME: z14ki00signdet.dgn	PLOT DATE: 5/5/2017
PROJECT LEADER: K. RUTTER	DRAWN BY: R. SHEDD
DESIGNED BY: R. SHEDD	CHECKED BY: K. RUTTER
TRAFFIC SIGN DETAIL SHEET 3	SHEET 17 OF 255