




DANVILLE

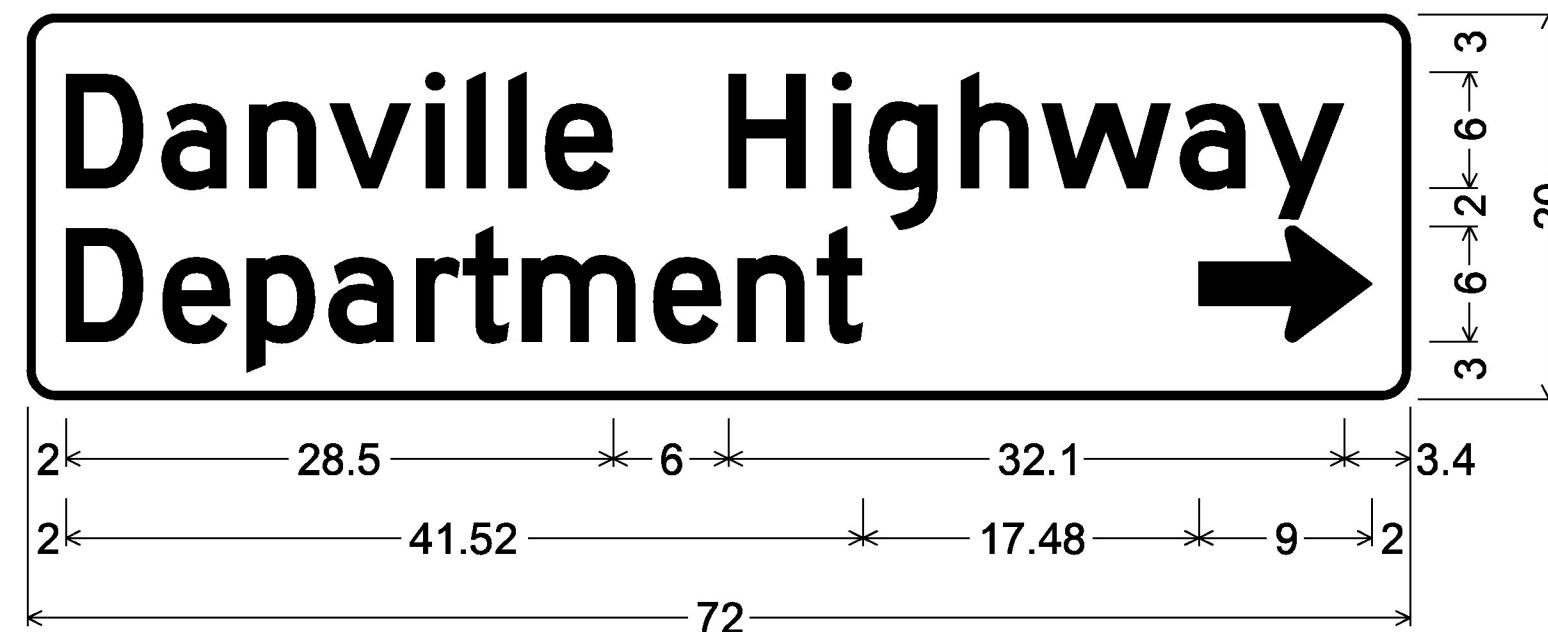

1.50" Radius, 0.38" Border, White on Green;
 [Danville Highway] D 2K; [Department] D 2K;
 Standard Arrow Custom 9.00" X 6.00" 0°;

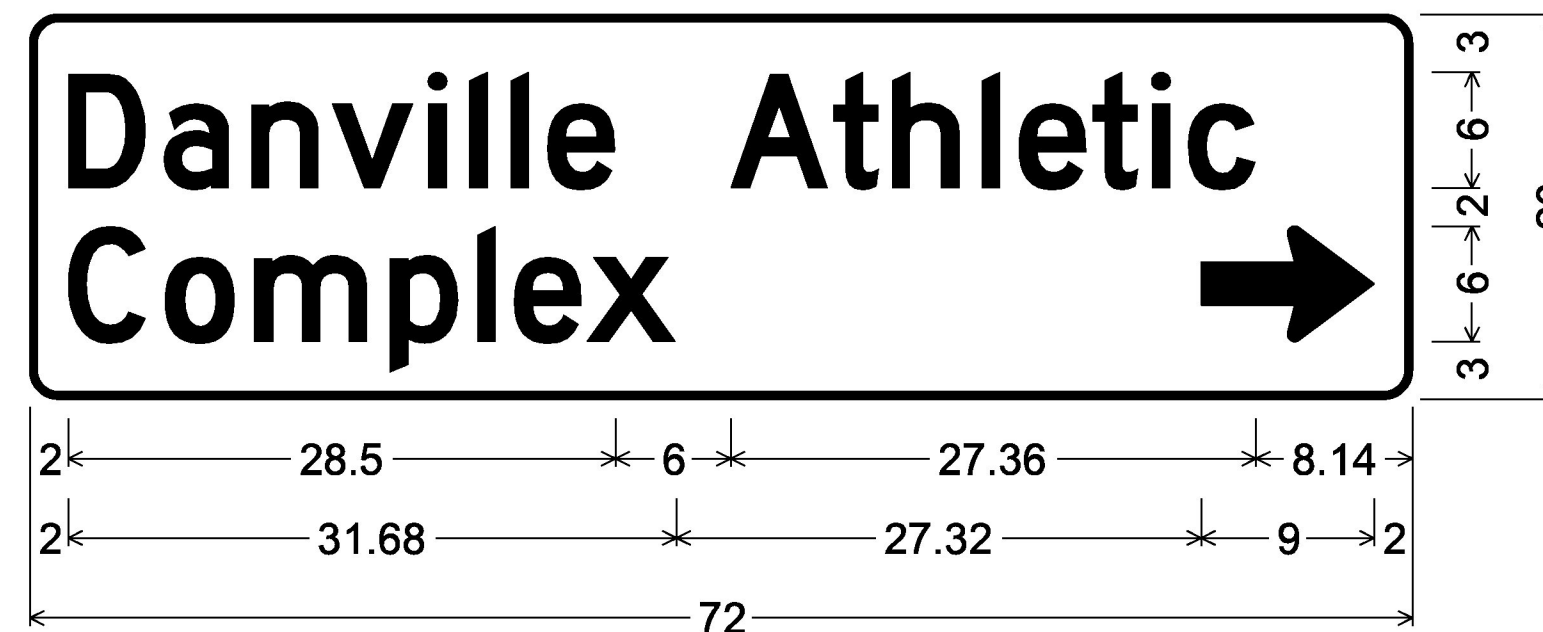


1.50" Radius, 0.38" Border, White on Green;
 [Danville Athletic] D 2K; [Complex] D 2K;
 Standard Arrow Custom 9.00" X 6.00" 0°;

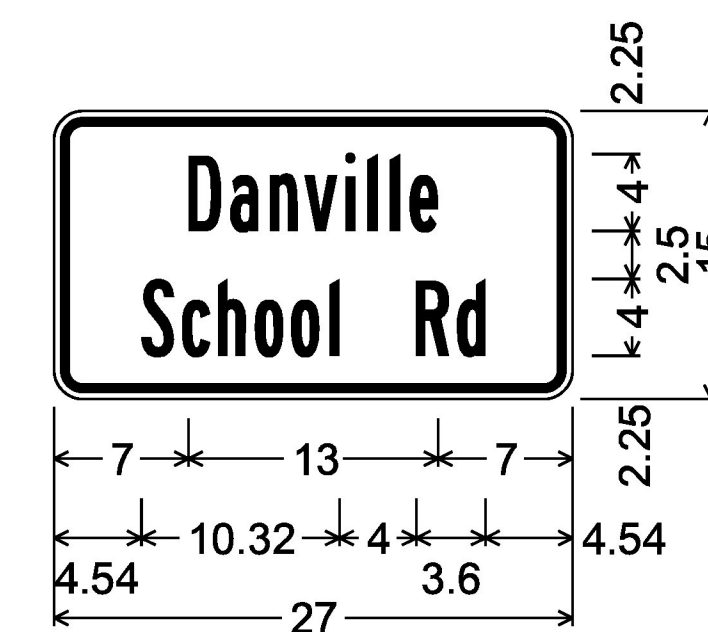


1.50" Radius, 0.38" Border,
 0.38" Indent, Black on Yellow;
 [Danville] B 2K;
 [School Rd] B 2K;

W16-8p

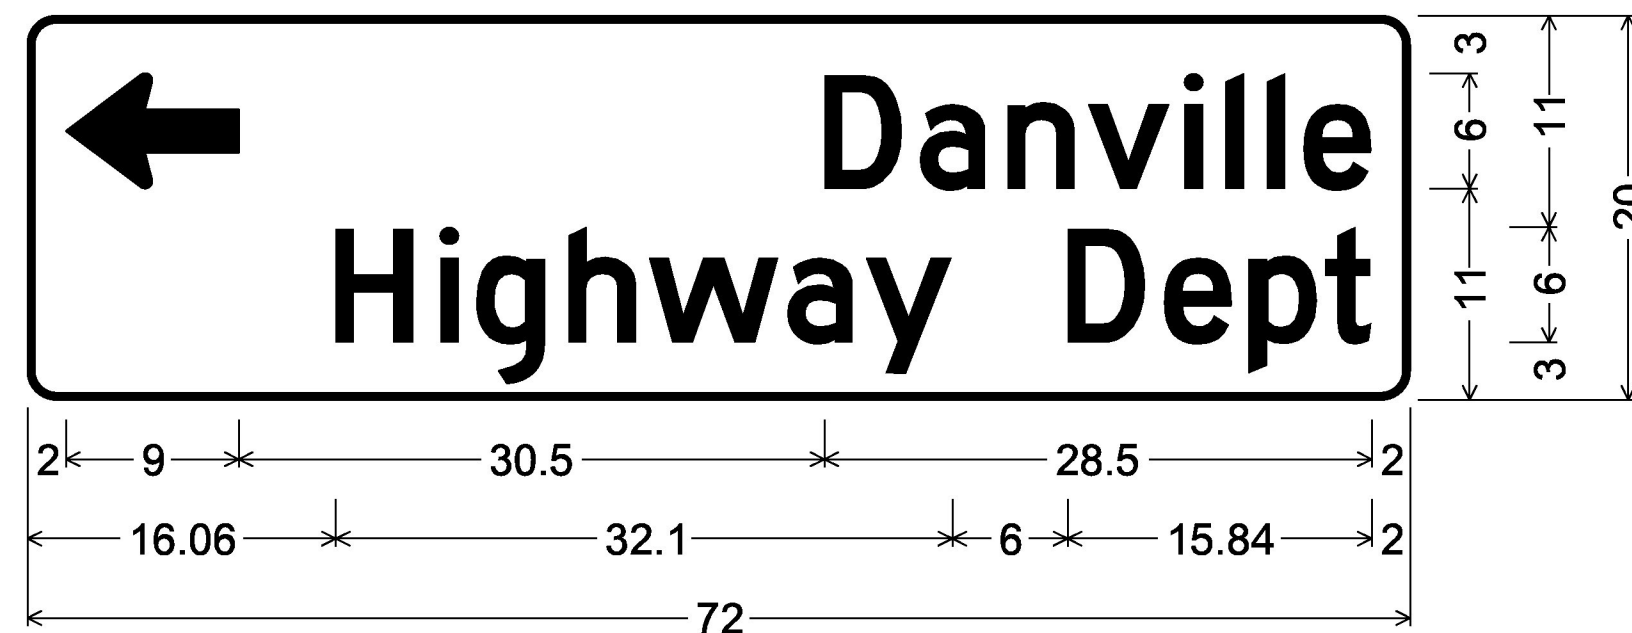


1.50" Radius, 0.38" Border, White on Green;
 Standard Arrow Custom 9.00" X 6.00" 180°; [Danville] D 2K;
 [Highway Dept] D 2K;

VD2-1S

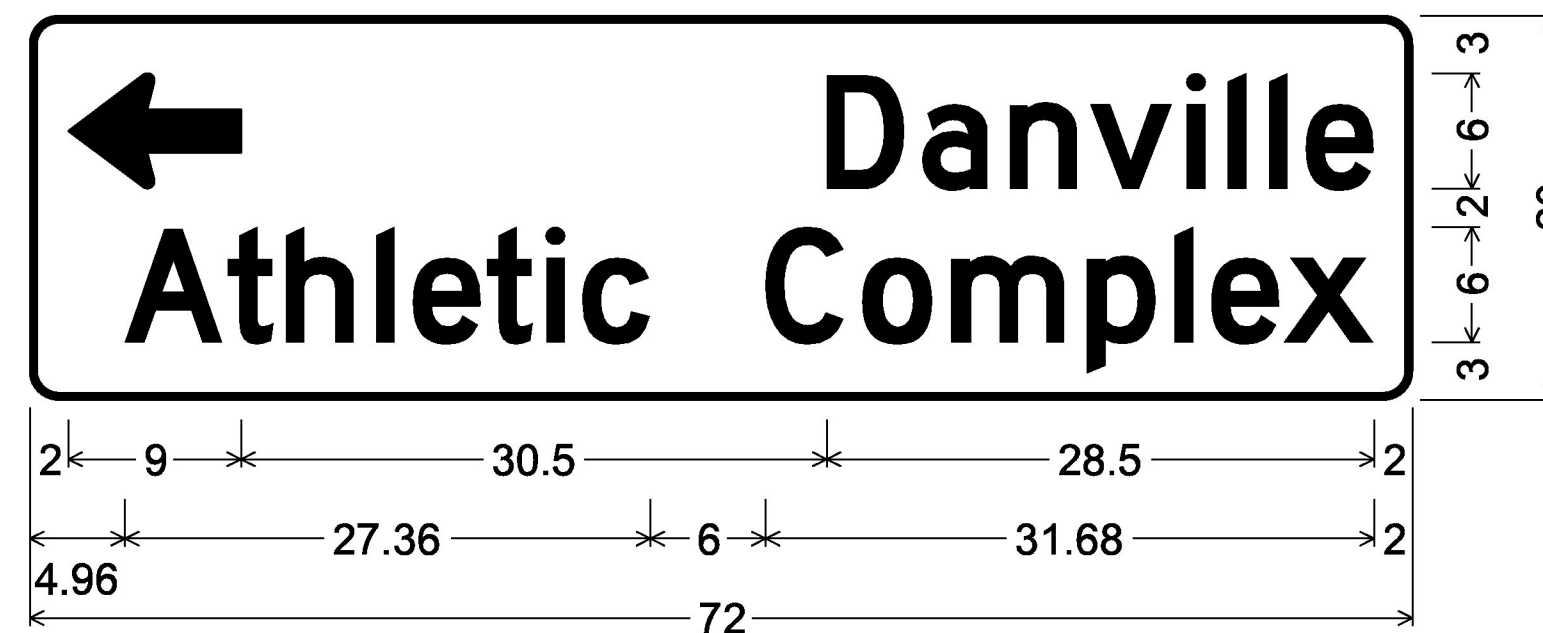


1.50" Radius, 0.38" Border, White on Green;
 Standard Arrow Custom 9.00" X 6.00" 180°; [Danville] D 2K;
 [Athletic Complex] D 2K;

VD2-1S

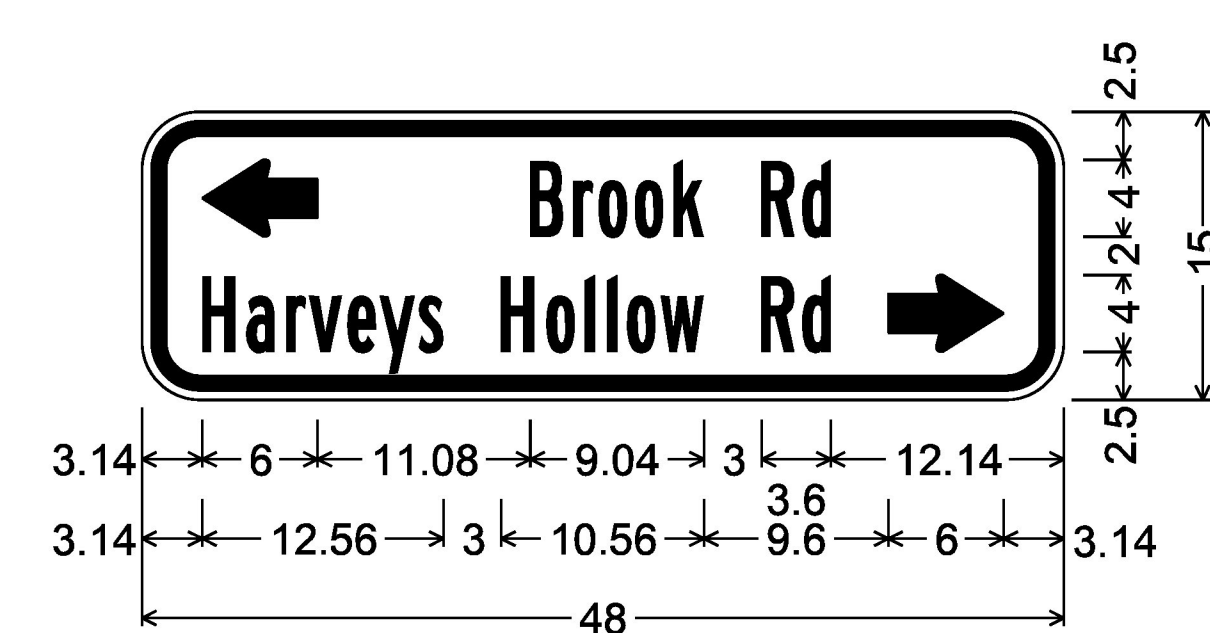


3.00" Radius, 0.75" Border, 0.50" Indent, Black on Yellow;
 Standard Arrow Custom 6.00" X 4.00" 180°;
 [Brook Rd] B 2K;
 [Harveys Hollow Rd] B 2K;
 Standard Arrow Custom 6.00" X 4.00" 0°;

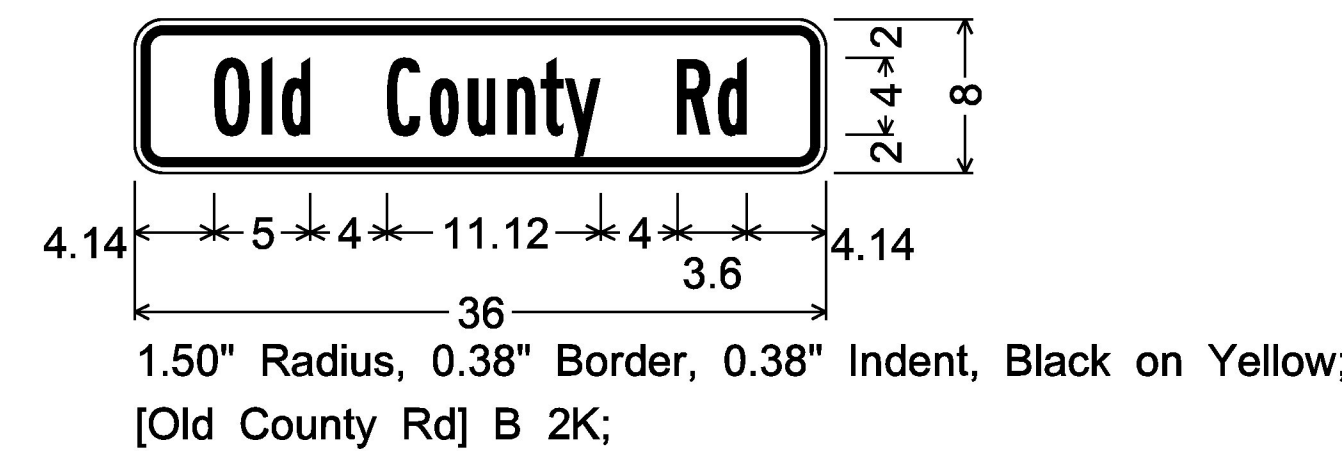

1.50" Radius, 0.38" Border, 0.38" Indent, Black on Yellow;
 [Old County Rd] B 2K;

W16-8p

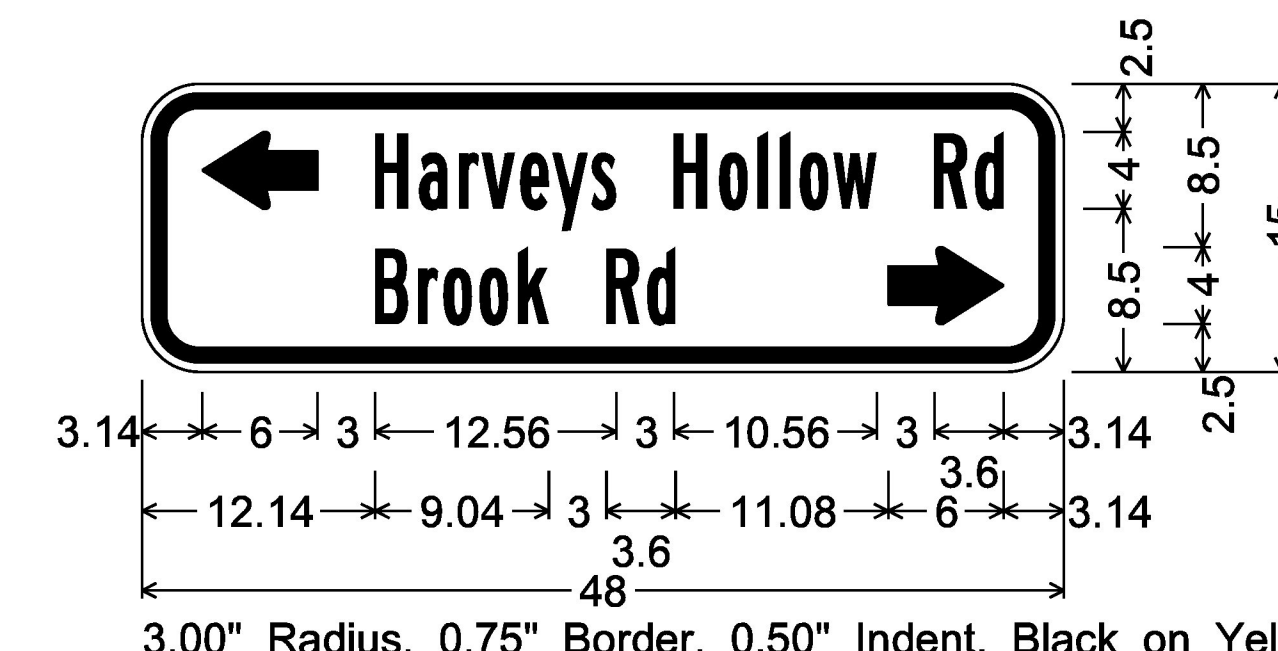

3.00" Radius, 0.75" Border, 0.50" Indent, Black on Yellow;
 Standard Arrow Custom 6.00" X 4.00" 180°;
 [Harveys Hollow Rd] B 2K;
 [Brook Rd] B 2K;
 Standard Arrow Custom 6.00" X 4.00" 0°;

W16-8a

| | |
|-----------------------------|------------------------|
| PROJECT NAME: | STATEWIDE NORTH REGION |
| PROJECT NUMBER: | STP HRRR(22) |
| FILE NAME: | z14ki00signdet.dgn |
| PROJECT LEADER: | K. RUTTER |
| DESIGNED BY: | R. SHEDD |
| TRAFFIC SIGN DETAIL SHEET 5 | |
| PLOT DATE: | 5/5/2017 |
| DRAWN BY: | R. SHEDD |
| CHECKED BY: | K. RUTTER |
| SHEET | 19 OF 255 |

NOT TO SCALE