





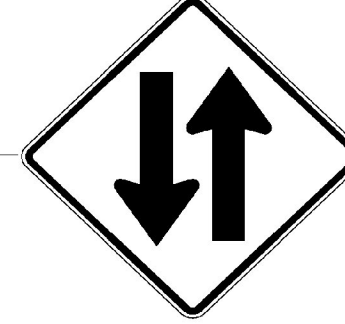
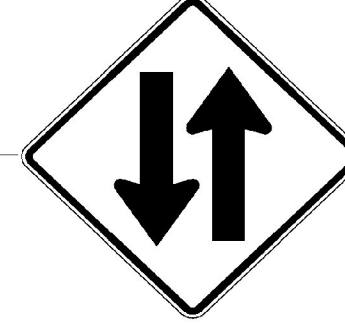





DIRECTION	MILEPOINT	LOCATION CODE (SHEET 4)	SIGN CODE	WIDTH (IN)	HEIGHT (IN)	SHEETING REMARKS	SIGN LEGEND	NEW SIGNS		EXISTING SIGNS			EXIST POST		NUMBER OF NEW POSTS	SQUARE STEEL (IN)			TUBULAR STEEL Ø (IN)				SIGN FRAME REQUIRED	REMARKS	SIGN DETAIL LOCATION				
								"A"	"B"	RETAIN	SALVAGE FROM	SALVAGE TO	REMOVE	RETAIN		REMOVE	1.75	2.00	2.50	FOUNDATION	3.00	3.50			4.00	5.00	SHSM	SIGN DETAIL SHEET #	STANDARD SHEET #
																	(LB / FT)				(LB / FT)								
SB BURLINGTON VT 127							FY-FLUORESCENT YELLOW FYG-FLUORESCENT YELLOW GREEN															"SHSM"-STANDARD HIGHWAY SIGNS AND MARKINGS BOOK							
SB	3.401	F	R2-1	30	36		 5-2-18	7.50														INSTALL ON BRIDGE ON LUMINAIRE POLE #10994 WITH APPROPRIATE BRACKET	X						
SB	3.199	F	R4-1				DO NOT PASS					1																	
		F					PROHIBITED PEDESTRIANS HITCH-HIKERS STOPPING FOR HITCH-HIKERS ANIMALS BICYCLES FARM MACHINERY SNOW VEHICLES					1																	
		F	D3-1				 5-1-18 MILE MARKER 1270 / 0403 / 0320					1																	
		F	R4-1	24	30		 5-1-187	5.00								2	16.50 X 16.75						X						
		F	VR-046	36	36		 5-1-187	9.00																	T-71				
		F	VD-700	6	10		1270 0403 0320 5-1-18	0.42														MOUNT ON LEFT POST			T-44				
SB	3.172	F					 5-1-18 TWO WAY TRAFFIC WARNING					1																	
		F		36	36		 5-1-18	9.00								2	14.25 X 15.00							27					
SB	3.099	F	W6-3				 5-1-18 TWO WAY TRAFFIC					1																	
		F	W6-3	36	36		 5-1-18	9.00								2	14.00 X 14.75						X						
SB	3.063	F	R2-1				 5-1-18 SPEED LIMIT 50					1																	
		F	R2-1	24	30		 5-1-18	5.00								1	14.25 X						X						
SB	2.999	E	W3-5	36	36		 5-1-18	9.00								2	14.50 X 14.75						X						
SIGN SUMMARY SHEET							SHEET TOTALS	53.92	0.00	0	0	0	6	0	0	9	134.75 135.0	0	0.0	0.0	0.0	0.0	PROJECT NAME: STATEWIDE-NORTH REGION						
								SF	SF	EA	EA	EA	EA	EA	EA	EA	FT	EA	LB	LB	LB	PROJECT NUMBER: STP HRRR(22)							
VERMONT AGENCY OF TRANSPORTATION							TOWN DIRECTIONAL TOTALS	53.9	0.0	0	0	0	6	0	0	9	135.0	0		0.0		FILE NAME: z14k100tssburlington VT127	PLOT DATE: 5/5/2017						
																				PROJECT MANAGER: K. RUTTER	DRAWN BY: R. SHEDD								
																				DESIGNED BY: R. SHEDD	CHECKED: S. GOODWIN								
																				BURLINGTON VT 127 SOUTHBOUND 1	SHEET 57	OF	255						