



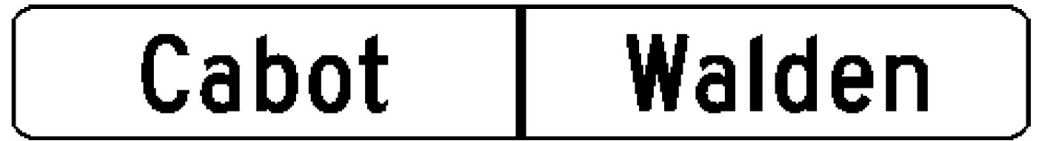

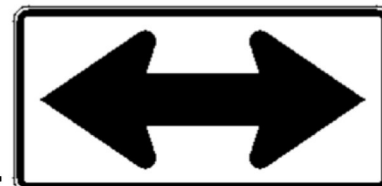


DIRECTION	MILEPOINT	LOCATION CODE (SHEET 4)	SIGN CODE	WIDTH (IN)	HEIGHT (IN)	SHEETING REMARKS	SIGN LEGEND	NEW SIGNS		EXISTING SIGNS			EXIST POST		NUMBER OF NEW POSTS	SQUARE STEEL (IN)			TUBULAR STEEL Ø (IN)				SIGN FRAME REQUIRED	REMARKS	SIGN DETAIL LOCATION				
								"A"	"B"	RETAIN	SALVAGE FROM	SALVAGE TO	REMOVE	RETAIN		REMOVE	1.75	2.00	2.50	FOUNDATION	3.00	3.50			4.00	5.00	SHSM	SIGN DETAIL SHEET #	STANDARD SHEET #
																	(LB / FT)				(LB / FT)								
SB CABOT TH-1							FY-FLUORESCENT YELLOW FYG-FLUORESCENT YELLOW GREEN															"SHSM"-STANDARD HIGHWAY SIGNS AND MARKINGS BOOK							
SB	6.765	F	D3-1				CABOT																6-1-18						
		F	D3-1				ROUTE 215 NORTH			1	1	1																	
		G	VD-024	72	10			5.00																		T-94			
SB	6.495	G	W1-7	48	24			8.00																X					
SB	5.969	EF	D3-1				PRANSKY RD					1																	
		EF	D3-1	42	12			3.50															MOUNT PRANSKY RD PERP ON TOP OF STOP SIGN		3				
		H	R1-1	30	30			6.25																X					
SB	4.654	F	W2-2L				LEFT INTERSECTION			1																			
SB	4.500	G	W1-7	48	24			8.00				1												X		SIGN 6-19-18			
SB	4.009	F	R2-5C				SPEED ZONE AHEAD					1																	
		F	VW-060				HIDDEN DRIVES					1																	
		F	W3-5	36	36			9.00																X					
SB	3.980	F	VW-060	30	30			6.25															INSTALL 150 FT ± SOUTH OF EXISTING SIGNS AT MP 4.009			T-81			
SB	3.930	F	R2-1				SPEED LIMIT 30					1																	
		F	R2-1	30	36			7.50																X					
SIGN SUMMARY SHEET							SHEET TOTALS	53.50	0.00	1	0	1	8	0	0	11	143.25	0	0.0	0.0	0.0	0.0	PROJECT NAME: STATEWIDE-NORTH REGION						
							SF	SF	EA	EA	EA	EA	EA	EA	EA	EA	FT	EA	LB	LB	LB	LB	PROJECT NUMBER: STP HRRR(22)						
VERMONT AGENCY OF TRANSPORTATION							TOWN DIRECTIONAL TOTALS	262.7	0.0	20	2	2	38	1	0	48	720.0	0				0.0	FILE NAME: z14k100tsscabot TH1 SB	PLOT DATE: 5/5/2017					
																							PROJECT MANAGER: K. RUTTER	DRAWN BY: R. SHEDD					
																								DESIGNED BY: R. SHEDD	CHECKED: S. GOODWIN	SHEET 67	OF 255		
																								CABOT TH-1 SOUTHBOUND 1					