




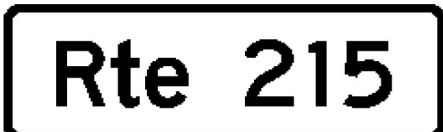



DIRECTION	MILEPOINT	LOCATION CODE (SHEET 4)	SIGN CODE	WIDTH (IN)	HEIGHT (IN)	SHEETING REMARKS	SIGN LEGEND	NEW SIGNS		EXISTING SIGNS			EXIST POST		NUMBER OF NEW POSTS	SQUARE STEEL (IN)			TUBULAR STEEL Ø (IN)				SIGN FRAME REQUIRED	REMARKS	SIGN DETAIL LOCATION				
								"A"	"B"	RETAIN	SALVAGE FROM	SALVAGE TO	REMOVE	RETAIN		REMOVE	1.75	2.00	2.50	FOUNDATION	3.00	3.50			4.00	5.00	SHSM	SIGN DETAIL SHEET #	STANDARD SHEET #
																	(LB / FT)				(LB / FT)								
SB CABOT TH-1							FY-FLUORESCENT YELLOW FYG-FLUORESCENT YELLOW GREEN															"SHSM"-STANDARD HIGHWAY SIGNS AND MARKINGS BOOK							
SB	2.378	E	OM3-L				OBJECT MARKER			1				X								6-11-18							
SB	2.056	EF	D3-1				WOOD SIGN DINGMAN RD				1																		
		EF	D3-1	52	12			4.33														INSTALL 10 FT. FROM PROPOSED STOP SIGN		2					
SB	2.056	H	R1-1	30	30			6.25																	X				
SB	1.863	G	R2-1				SPEED LIMIT 35				1											REMOVE 600 FT ± FROM RTE 215							
		G	R2-1	24	30			5.00														INSTALL 216 FT ± FROM RTE 215			X				
SB	1.857	H	W3-1	30	30			6.25														INSTALL 600 FT ± FROM RTE 215, BY EXISTING SPEED ZONE AHEAD SIGN			X				
SB	1.857	H	R2-5C				SPEED ZONE AHEAD				1																		
SB	1.857	H	R1-1				STOP				1											6-12-18							
		H	R1-1	30	30			6.25			1	1	1												X				
SB	1.857	EF	D3-1				ROUTE 215 S					1																	
		H	D3-1				WEST HILL POND RD					1																	
		GH	D3-1	36	12			3.00																	2				
		EF	D3-1	72	12			6.00																	3				
SIGN SUMMARY SHEET							SHEET TOTALS	37.08	0.00	1	0	1	8	0	0	8	102.50	0	0.0	0.0	0.0	0.0		PROJECT NAME: STATEWIDE-NORTH REGION					
																							PROJECT NUMBER: STP HRRR(22)						
VERMONT AGENCY OF TRANSPORTATION							TOWN DIRECTIONAL TOTALS	262.7	0.0	20	2	2	38	1	0	48	720.0	0		0.0			FILE NAME: z14k100tsscabot TH1 SB	PLOT DATE: 5/5/2017					
																						PROJECT MANAGER: K. RUTTER	DRAWN BY: R. SHEDD						
																						DESIGNED BY: R. SHEDD	CHECKED: S. GOODWIN						
																						CABOT TH-1 SOUTHBOUND 6	SHEET 72	OF	255				