






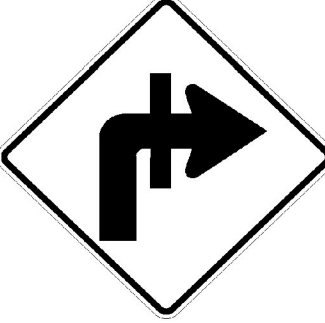

DIRECTION	MILEPOINT	LOCATION CODE (SHEET 4)	SIGN CODE	WIDTH (IN)	HEIGHT (IN)	SHEETING REMARKS	SIGN LEGEND	NEW SIGNS		EXISTING SIGNS			EXIST POST		NUMBER OF NEW POSTS	SQUARE STEEL (IN)			TUBULAR STEEL Ø (IN)				SIGN FRAME REQUIRED	REMARKS	SIGN DETAIL LOCATION				
								"A"	"B"	RETAIN	SALVAGE FROM	SALVAGE TO	REMOVE	RETAIN		REMOVE	1.75 (LB / FT)	2.00	2.50	FOUNDATION	3.00	3.50			4.00	5.00	SHSM	SIGN DETAIL SHEET #	STANDARD SHEET #
NB DANVILLE TH-3							FY-FLUORESCENT YELLOW FYG-FLUORESCENT YELLOW GREEN															"SHSM"-STANDARD HIGHWAY SIGNS AND MARKINGS BOOK 5-18-18							
NB	1.183	A	W1-1MhR	36	36		  	9.00							2	15.75 X 16.25							INSTALL 85 FT ± NORTH OF EXISTING UTILITY POST 54/48/64 AT MP 1.167		26				
		A	W16-8a	48	15			5.00																	5				
		A	W13-1p	18	18			2.25															INSTALL ON LEFT POST	X					
NB	1.226	A	OM3-R	12	36		 	3.00							1	10.75 X								X					
NB	1.237	B	OM3-L			OBJECT MARKER						1		X									5-19-18						
		B	OM3-L	12	36			3.00							1	10.75 X							X						
NB	1.248	AB	D3-1				BROOK RD					1										5-18-18							
		D	R1-1				STOP					1																	
NB	1.460	A	VW-133R	30	30			6.25							1	14.75 X							INSTALL 550 FT ± SOUTH OF EXISTING SIGN AT MP 1.564			T-81			
NB	1.564	A					END SPEED 35					1		X															
NB	1.587	A	R2-1	24	30			5.00							1	14.00 X							INSTALL 120 FT ± NORTH OF REMOVED SIGN AT MP 1.564	X					
NB	1.992	A		6	8		INSTALL (1) NEW DELINEATOR POST																5-19-18 INSTALL (1) TYPE II 6"x8" WHITE DELINEATOR ON ONE NEW POST; INSTALL POST AT MP 1.992, 1,000 FT ± SOUTH OF UTILITY POLE 19/33-01 AT MP 2.182, SEE SHEET 9						
NB	2.075	B		6	8		INSTALL (1) NEW DELINEATOR POST																2 DEL. INSTALL (1) TYPE II 6"x8" WHITE DELINEATOR ON ONE NEW POST; INSTALL POST AT MP 2.075, 560 FT ± SOUTH OF UTILITY POLE 19/33-01 AT MP 2.182, SEE SHEET 9						
SIGN SUMMARY SHEET							SHEET TOTALS	33.50	0.00	2	0	0	2	0	0	6	82.25 90.0	0	0.0	0.0	0.0	0.0	PROJECT NAME: STATEWIDE-NORTH REGION						
VERMONT AGENCY OF TRANSPORTATION							TOWN DIRECTIONAL TOTALS	163.3	0.0	14	0	0	10	0	0	30	450.0	0		0.0		PROJECT NUMBER: STP HRRR(22)							
																					FILE NAME: z14k100tssdanville TH3 NB.xl	PLOT DATE: 5/5/2017							
																					PROJECT MANAGER: K. RUTTER	DRAWN BY: R. SHEDD							
																					DESIGNED BY: R. SHEDD	CHECKED: S. GOODWIN							
																					DANVILLE TH-3 NORTHBOUND 3	SHEET 77	OF	255					