
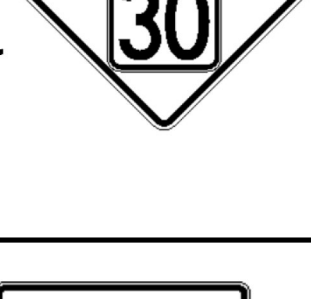
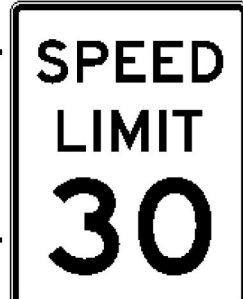

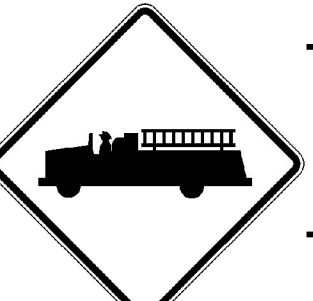





DIRECTION	MILEPOINT	LOCATION CODE (SHEET 4)	SIGN CODE	WIDTH (IN)	HEIGHT (IN)	SHEETING REMARKS	SIGN LEGEND	NEW SIGNS		EXISTING SIGNS			EXIST POST		NUMBER OF NEW POSTS	SQUARE STEEL (IN)			TUBULAR STEEL Ø (IN)				SIGN FRAME REQUIRED	REMARKS	SIGN DETAIL LOCATION				
								"A"	"B"	RETAIN	SALVAGE FROM	SALVAGE TO	REMOVE	RETAIN		REMOVE	1.75	2.00	2.50	FOUNDATION	3.00	3.50			4.00	5.00	SHSM	SIGN DETAIL SHEET #	STANDARD SHEET #
																	(LB / FT)				(LB / FT)								
NB DANVILLE TH-3							FY-FLUORESCENT YELLOW FYG-FLUORESCENT YELLOW GREEN															"SHSM"-STANDARD HIGHWAY SIGNS AND MARKINGS BOOK							
NB	2.182	A	W1-2L	30	30			6.25							1	15.25	X							5-21-18	X				
NB	2.613	A	W3-5	36	36			9.00							2	13.75	X							INSTALL 185 FT ± NORTH OF UTILITY POLE 27 AT MP 2.578	X				
NB	2.669	A	R2-1	30	36			7.50							1	13.75	X							INSTALL 775 FT ± SOUTH OF EXISTING SIGN AT MP 2.816	X				
NB	2.816	A	R2-1										1		X									SPEED LIMIT 25					
		A	R2-1	30	36			7.50						1	13.75	X									X				
NB	2.890	A	W8-6								1				X									TRAIL CROSSING					
		A	W16-9p								1													AHEAD					
NB	2.900	A	W11-8	30	30			6.25							1	14.25	X							INSTALL ACROSS FROM UTILITY POLE 14 AT SB MP 2.900	X				
NB	2.911	A	W8-6								1													TRAIL CROSSING					
		A	W16-7p								1				X									LEFT DOWN ARROW					
NB	2.986	A	D3-1								1				X									CEDAR LN					
		D	R1-1								1													STOP					
NB	3.079	A	W2-2L	30	30			6.25							1	16.75	X							INSTALL 15 FT ± SOUTH OF UTILITY POLE 8/NET/7	X				
		A	W16-8p	27	15			2.81																			5		
NB	3.125	A	W1-7	48	24			8.00							2	13.25	X							INSTALL ACROSS FROM DANVILLE SCHOOL RD INTERSECTION	X				
SIGN SUMMARY SHEET							SHEET TOTALS	53.56	0.00	6	0	0	1	0	0	9	128.50		0	0.0	0.0	0.0	0.0	PROJECT NAME: STATEWIDE-NORTH REGION					
							SF	SF	EA	EA	EA	EA	EA	EA	EA	EA	FT	EA	LB	LB	LB	LB	PROJECT NUMBER: STP HRRR(22)						
VERMONT AGENCY OF TRANSPORTATION							TOWN DIRECTIONAL TOTALS	163.3	0.0	14	0	0	10	0	0	30	450.0		0			0.0		FILE NAME: z14k100tssdanville TH3 NB.xl	PLOT DATE: 5/5/2017				
																							PROJECT MANAGER: K. RUTTER	DRAWN BY: R. SHEDD					
																							DESIGNED BY: R. SHEDD	CHECKED: S. GOODWIN					
																							DANVILLE TH-3 NORTHBOUND 4	SHEET 78	OF 255				