










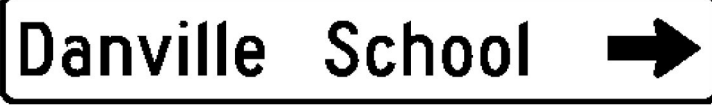

DIRECTION	MILEPOINT	LOCATION CODE (SHEET 4)	SIGN CODE	WIDTH (IN)	HEIGHT (IN)	SHEETING REMARKS	SIGN LEGEND	NEW SIGNS		EXISTING SIGNS			EXIST POST		NUMBER OF NEW POSTS	SQUARE STEEL (IN)			TUBULAR STEEL Ø (IN)				SIGN FRAME REQUIRED	REMARKS	SIGN DETAIL LOCATION				
								"A"	"B"	RETAIN	SALVAGE FROM	SALVAGE TO	REMOVE	RETAIN		REMOVE	1.75	2.00	2.50	FOUNDATION	3.00	3.50			4.00	5.00	SHSM	SIGN DETAIL SHEET #	STANDARD SHEET #
																	(LB / FT)				(LB / FT)								
SB DANVILLE TH-3							FY-FLUORESCENT YELLOW FYG-FLUORESCENT YELLOW GREEN															"SHSM"-STANDARD HIGHWAY SIGNS AND MARKINGS BOOK							
SB	3.171	F	W2-2R	30	30			6.25						1	15.00 X							INSTALL 260 FT ± NORTH OF EXISTING SIGN AT MP 3.122 5-22-18	X						
		F	W16-8p	27	15			3.13															5						
SB	3.122	F	VD1-1	72	12			6.00						2	12.00 X 13.00							INSTALL BACK TO BACK IN FRONT OF STOP SIGN		4	T-93				
		E	VD1-1	72	12			6.00															4	T-93					
SB	3.122	H	R1-1				 STOP															MISSING							
		H	R1-1	30	30			6.25						1	13.75 X									X					
SB	3.039	H	W11-8	30	30			6.25						1	13.75 X							INSTALL 40 FT ± SOUTH OF AND ACROSS FROM UTILITY POLE 19/9/8/320/20 AT MP 3.047	X						
SB	2.938	F	W8-6				TRAIL CROSSING			1																			
		F	W16-9p				AHEAD			1																			
SB	2.918	F	W8-6				TRAIL CROSSING			1																			
		F	W16-7p				LEFT DOWN ARROW			1																			
SB	2.821	F	VD1-2S	72	20			10.00						2	14.75 X 14.50							INSTALL BACK TO BACK ACROSS THE ROAD FROM UTILITY POLE 21/15/3		5	T-93				
		F	VD1-2S	72	20			10.00														SLIP BASE REQUIRED SEE SHEET 9		5	T-93				
		E	VD1-2S	72	20			10.00																5	T-93				
		E	VD1-2S	72	20			10.00																5	T-93				
SIGN SUMMARY SHEET							SHEET TOTALS	73.88	0.00	4	0	0	0	0	0	7	96.75 105.0	0	0.0	0.0	0.0	0.0	PROJECT NAME: STATEWIDE-NORTH REGION						
							TOWN DIRECTIONAL TOTALS	215.6	0.0	6	0	0	19	0	0	34	510.0	0		0.0		PROJECT NUMBER: STP HRRR(22)							
VERMONT AGENCY OF TRANSPORTATION								SF	SF	EA	EA	EA	EA	EA	EA	EA	FT	EA	LB	LB	LB	FILE NAME: z14k100tssdanvilleTH3 SB.xls	PLOT DATE: 5/5/2017						
																					PROJECT MANAGER: K. RUTTER	DRAWN BY: R. SHEDD							
																					DESIGNED BY: R. SHEDD	CHECKED: S. GOODWIN							
																					DANVILLE TH-3 SOUTHBOUND 1	SHEET 79	OF	255					

2 SLIP BASES