


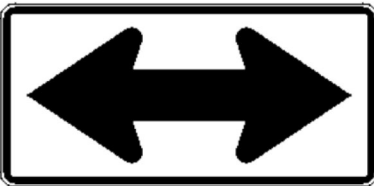


DIRECTION	MILEPOINT	LOCATION CODE (SHEET 4)	SIGN CODE	WIDTH (IN)	HEIGHT (IN)	SHEETING REMARKS	SIGN LEGEND	NEW SIGNS		EXISTING SIGNS			EXIST POST		NUMBER OF NEW POSTS	SQUARE STEEL (IN)			TUBULAR STEEL Ø (IN)				SIGN FRAME REQUIRED	REMARKS	SIGN DETAIL LOCATION				
								"A"	"B"	RETAIN	SALVAGE FROM	SALVAGE TO	REMOVE	RETAIN		REMOVE	1.75	2.00	2.50	FOUNDATION	3.00	3.50			4.00	5.00	SHSM	SIGN DETAIL SHEET #	STANDARD SHEET #
																	(LB / FT)				(LB / FT)								
SB FAIRFIELD TH-1							FY-FLUORESCENT YELLOW FYG-FLUORESCENT YELLOW GREEN															"SHSM"-STANDARD HIGHWAY SIGNS AND MARKINGS BOOK							
SB	0.308	F					PRES. ARTHUR HISTORICAL SITE				1				2								INSTALL 200 FT ± NORTH OF SALVAGED SIGN LOCATION.						
SB	0.270	F					PRES. ARTHUR HISTORICAL SITE			1		1											6-15-18						
SB	0.270						BEACON																						
		F	W2-2L	36	36			9.00							2									X					
		F	W16-8p	48	8			2.67																	6				
SB	0.179	G	W4-4p	36	18																		THIS BEACON IS TO BE ACTIVATED WIRELESSLY ONLY WHEN A NORTHBOUND VEHICLE IS PASSING DETECTION AREA . FLASHING TIME SHALL BE DETERMINED IN THE FIELD FOLLOWING MANUFACTURER RECOMENDATIONS. PAID FOR AS ITEM NO. 900.645 SPECIAL PROVISION (ADVANCED FLASHING BEACON SYSTEM, SOLAR POWERED)	X					
SB	0.179	G	W1-7	48	24			8.00							2								INSTALL ACROSS FROM CHESTER A ARTHUR RD INTERSECTION	X					
SIGN SUMMARY SHEET							SHEET TOTALS	19.67	0.00	0	1	1	1	0	0	6							PROJECT NAME: STATEWIDE-NORTH REGION						
								SF	SF	EA	EA	EA	EA	EA	EA	EA							PROJECT NUMBER: STP HRRR(22)						
VERMONT AGENCY OF TRANSPORTATION							TOWN DIRECTIONAL TOTALS	19.7	0.0	0	1	1	1	0	0	6	90.0						FILE NAME: z14k100tssfairfield TH1 SB.xl	PLOT DATE: 5/30/2017					
																							DESIGNED BY: R. SHEDD	DRAWN BY: R. SHEDD					
																							CHECKED: S. GOODWIN	SHEET 85	OF 255				