

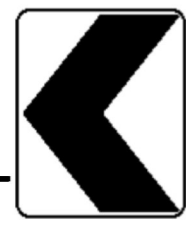

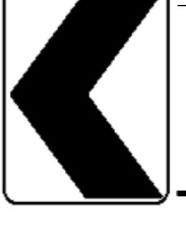

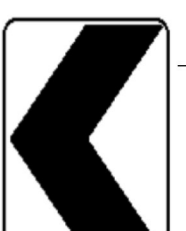



DIRECTION	MILEPOINT	LOCATION CODE (SHEET 4)	SIGN CODE	WIDTH (IN)	HEIGHT (IN)	SHEETING REMARKS	SIGN LEGEND	NEW SIGNS		EXISTING SIGNS			EXIST POST		NUMBER OF NEW POSTS	SQUARE STEEL (IN)			TUBULAR STEEL Ø (IN)				SIGN FRAME REQUIRED	REMARKS	SIGN DETAIL LOCATION				
								"A"	"B"	RETAIN	SALVAGE FROM	SALVAGE TO	REMOVE	RETAIN		REMOVE	1.75	2.00	2.50	FOUNDATION	3.00	3.50			4.00	5.00	SHSM	SIGN DETAIL SHEET #	STANDARD SHEET #
																	(LB / FT)				(LB / FT)								
NB FLETCHER TH-2							FY-FLUORESCENT YELLOW FYG-FLUORESCENT YELLOW GREEN															"SHSM"-STANDARD HIGHWAY SIGNS AND MARKINGS BOOK							
NB	1.626	A	W1-1MdL	36	36			9.00						2	16.00 X 17.00								INSTALL 260 FT ± NORTH OF EXISTING SIGN AT MP 1.577 4-17-18		27				
		A	W13-1p	18	18			2.25														INSTALL ON LEFT POST	X						
NB	1.632																					REMOVE EMPTY POST							
NB	1.665	A	W1-8	24	30			5.00						1	14.00 X								PAID FOR AS ITEM 676.12, REMOVAL OF EXISTING DELINEATOR, SEE SHEET 7						
NB	1.666	B	W1-8	24	30			5.00						1	14.00 X								INSTALL 65 FT ± SOUTH OF EXISTING SIGNS AT MP 1.678	X					
NB	1.678	A	W1-8																										
		B	W1-8																										
		A	W1-8	24	30			5.00						1	13.75 X														
NB	1.679	B	W1-8	24	30			5.00						1	14.75 X														
NB	1.691	A	W1-8																										
		B	W1-8																										
		A	W1-8	24	30			5.00						1	14.25 X														
NB	1.692	B	W1-8	24	30			5.00						1	14.50 X														
SIGN SUMMARY SHEET							SHEET TOTALS	41.25	0.00	0	0	0	4	0	0	8	118.25 120.0	0	0.0	0.0	0.0	0.0		PROJECT NAME: STATEWIDE-NORTH REGION					
								SF	SF	EA	EA	EA	EA	EA	EA	EA	EA	EA	EA	EA	EA	EA		PROJECT NUMBER: STP HRRR(22)					
VERMONT AGENCY OF TRANSPORTATION							TOWN DIRECTIONAL TOTALS	290.0	0.0	1	0	0	28	0	0	56	840.0	0		0.0				FILE NAME: z14k100tssfletcherTH2 NB.xls	PLOT DATE: 5/5/2017				
																							PROJECT MANAGER: K. RUTTER	DRAWN BY: R. SHEDD					
																							DESIGNED BY: R. SHEDD	CHECKED: S. GOODWIN					
																							FLETCHER TH-2 NORTHBOUND 3	SHEET 91	OF	255			

1 DEL. REM.