


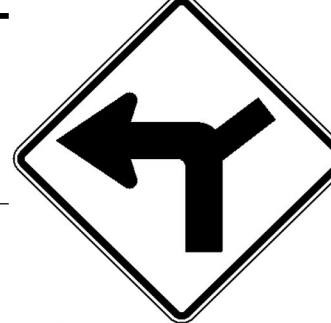








DIRECTION	MILEPOINT	LOCATION CODE (SHEET 4)	SIGN CODE	WIDTH (IN)	HEIGHT (IN)	SHEETING REMARKS	SIGN LEGEND	NEW SIGNS		EXISTING SIGNS			EXIST POST		NUMBER OF NEW POSTS	SQUARE STEEL (IN)			TUBULAR STEEL Ø (IN)				SIGN FRAME REQUIRED	REMARKS	SIGN DETAIL LOCATION				
								"A"	"B"	RETAIN	SALVAGE FROM	SALVAGE TO	REMOVE	RETAIN		REMOVE	1.75	2.00	2.50	FOUNDATION	3.00	3.50			4.00	5.00	SHSM	SIGN DETAIL SHEET #	STANDARD SHEET #
																	(LB / FT)				(LB / FT)								
SB FLETCHER TH-2							FY-FLUORESCENT YELLOW FYG-FLUORESCENT YELLOW GREEN															"SHSM"-STANDARD HIGHWAY SIGNS AND MARKINGS BOOK							
SB	2.170	F	W1-1MdR	36	36	  								9.00				2	15.75 X 16.50						INSTALL 295 FT ± SOUTH OF EXISTING SIGN AT MP 2.226 4-27-18		27		
		F	W16-8p	24	8										1.33												7		
		F	W13-1p	18	18										2.25									INSTALL ON LEFT POST	X				
SB	2.025	F					GRAVEL ROAD SURFACE				1														4-18-18				
SB	1.900	F	W1-1MdL	36	36	  								9.00				2	16.50 X 17.25						INSTALL 210 FT ± NORTH OF REPLACED SIGNS AT MP 1.860		27		
		F	W16-8p	24	8										1.33												7		
		F	W13-1p	18	18										2.25									INSTALL ON LEFT POST	X				
SB	1.860	F	W1-8				LEFT CHEVRON				1																		
		F	W1-8	24	30									5.00				1	13.25 X							X			
SB	1.859	E	W1-8				RIGHT CHEVRON				1																		
		E	W1-8	24	30									5.00				1	13.75 X							X			
SB	1.848	EF	D3-1				RUGG RD				1																		
		EF	D3-1	36	12									3.00				1	12.50 X								7		
SB	1.848	F	W1-8	18	24		LEFT CHEVRON				1																		
		F	W1-8	24	30									5.00				1	13.75 X							X			
SIGN SUMMARY SHEET							SHEET TOTALS	43.17	0.00	1	0	0	4	0	0	8	119.25 120.0	0	0.0	0.0	0.0	0.0	PROJECT NAME: STATEWIDE-NORTH REGION PROJECT NUMBER: STP HRRR(22)						
VERMONT AGENCY OF TRANSPORTATION							TOWN DIRECTIONAL TOTALS	282.5	0.0	1	0	0	28	0	0	52	780.0	0		0.0			FILE NAME: z14k100tssfletcherTH2 SB.xls PLOT DATE: 5/5/2017 PROJECT MANAGER: K. RUTTER DRAWN BY: R. SHEDD DESIGNED BY: R. SHEDD CHECKED: S. GOODWIN FLETCHER TH-2 SOUTHBOUND 3 SHEET 98 OF 255						