


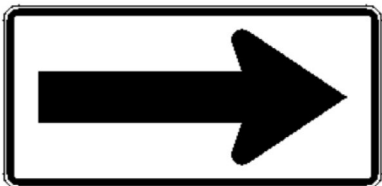





DIRECTION	MILEPOINT	LOCATION CODE (SHEET 4)	SIGN CODE	WIDTH (IN)	HEIGHT (IN)	SHEETING REMARKS	SIGN LEGEND	NEW SIGNS		EXISTING SIGNS			EXIST POST		NUMBER OF NEW POSTS	SQUARE STEEL (IN)			TUBULAR STEEL Ø (IN)				SIGN FRAME REQUIRED	REMARKS	SIGN DETAIL LOCATION				
								"A"	"B"	RETAIN	SALVAGE FROM	SALVAGE TO	REMOVE	RETAIN		REMOVE	1.75	2.00	2.50	FOUNDATION	3.00	3.50			4.00	5.00	SHSM	SIGN DETAIL SHEET #	STANDARD SHEET #
																	(LB / FT)				(LB / FT)								
EB GEORGIA TH-31							FY-FLUORESCENT YELLOW FYG-FLUORESCENT YELLOW GREEN															"SHSM"-STANDARD HIGHWAY SIGNS AND MARKINGS BOOK							
EB	0.010	B	R1-1				 STOP															4-18-18							
		B	R1-1	30	30			6.25														X							
EB	0.019	A	VR-079				 LEGAL LOAD AS FOR STATE HIGHWAYS																SLIP BASE REQUIRED SEE SHEET 9			T-70			
		A	VR-017	24	30			5.00																					
		A	R2-1	24	30			5.00														X							
EB	0.024	B	W1-6				 LARGE ARROW																4-19-18						
		A	W1-6	48	24			8.00																					
EB	0.031	A	W1-6	48	24			8.00															INSTALL 35 FT ± EAST OF EXISTING SIGN AT MP 0.031						
EB	0.039	A	R2-1				SPEED LIMIT 35																4-18-18						
EB	0.063	A	W1-2R				 RIGHT CURVE																						
		A	W1-2R	30	30			6.25																					
EB	0.095	A	D4-2				PARK & RIDE ←-----			1																			
EB	0.273	AB	D3-1				MORSE RD																4-17-18						
		AB	D3-1	40	12			3.33																		9			
EB	0.273	H	R1-1				STOP																						
SIGN SUMMARY SHEET							SHEET TOTALS	41.83	0.00	1	0	0	7	0	0	8	88.50	0	0.0	0.0	0.0	0.0	PROJECT NAME: STATEWIDE-NORTH REGION						
							SF	SF	EA	EA	EA	EA	EA	EA	EA	EA	FT	EA	LB	LB	LB	LB	PROJECT NUMBER: STP HRRR(22)						
VERMONT AGENCY OF TRANSPORTATION							TOWN DIRECTIONAL TOTALS	187.5	0.0	1	1	1	23	0	0	37	555.0	0		0.0			FILE NAME: z14k100tssaGeorgiaTH31 EB.xl PLOT DATE: 5/5/2017						
																						PROJECT MANAGER: K. RUTTER DRAWN BY: R. SHEDD							
																						DESIGNED BY: R. SHEDD CHECKED: S. GOODWIN							
																						GEORGIA TH-31 EASTBOUND 1 SHEET 102 OF 255							