






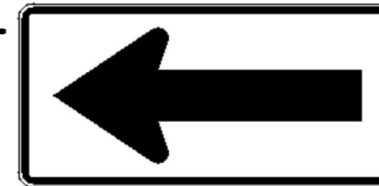


DIRECTION	MILEPOINT	LOCATION CODE (SHEET 4)	SIGN CODE	WIDTH (IN)	HEIGHT (IN)	SHEETING REMARKS	SIGN LEGEND	NEW SIGNS		EXISTING SIGNS			EXIST POST		NUMBER OF NEW POSTS	SQUARE STEEL (IN)			TUBULAR STEEL Ø (IN)				SIGN FRAME REQUIRED	REMARKS	SIGN DETAIL LOCATION				
								"A"	"B"	RETAIN	SALVAGE FROM	SALVAGE TO	REMOVE	RETAIN		REMOVE	1.75	2.00	2.50	FOUNDATION	3.00	3.50			4.00	5.00	SHSM	SIGN DETAIL SHEET #	STANDARD SHEET #
																	(LB / FT)				(LB / FT)								
EB GEORGIA TH-31							FY-FLUORESCENT YELLOW FYG-FLUORESCENT YELLOW GREEN															"SHSM"-STANDARD HIGHWAY SIGNS AND MARKINGS BOOK							
EB	1.111	A	VR-017				LLL 24,000 LBS															4-17-18							
		A	R2-1				SPEED LIMIT 35																						
		A					NO THRU TRUCKS																						
		B	VR-079				LEGAL LOAD AS FOR STATE HIGHWAYS																						
EB	1.155	A	W16-18p	24	12	FY	   	2.00							1				17.00 X					INSTALL 230 FT ± EAST OF REMOVED SIGNS AT MP 1.111		25			
		A	VR-017	24	30			5.00														SLIP BASE REQUIRED SEE SHEET 9			T-70				
		A	R2-1	24	30			5.00															X						
		B	VR-079	24	30			5.00														INSTALL BACK TO BACK			T-71				
EB	1.258	A	W13-1p				15 MPH (PLAQUE)															4-18-18							
		A	W1-2L				CURVE WARNING																						
		A					BLIND DRIVE																						
		A	W1-1L	30	30			6.25							1				15.00 X					X					
		A	W13-1p	18	18			2.25															X						
EB	1.283	A	VW-060	30	30			6.25							1				14.75 X				INSTALL 130 FT ± EAST IF EXISTING SIGNS AT MP 1.258			T-81			
EB	1.317	A	W1-6	48	24			8.00							2				13.00 X				INSTALL 180 FT ± EAST OF PROPOSED SIGN AT MP 1.283	X					
SIGN SUMMARY SHEET							SHEET TOTALS	39.75	0.00	0	0	0	7	0	0	5	59.75 75.0	0	0.0	0.0	0.0	0.0	PROJECT NAME: STATEWIDE-NORTH REGION PROJECT NUMBER: STP HRRR(22)						
VERMONT AGENCY OF TRANSPORTATION							TOWN DIRECTIONAL TOTALS	187.5	0.0	1	1	1	23	0	0	37	555.0	0			0.0		FILE NAME: z14k100tssaGeorgiaTH31 EB.xl PLOT DATE: 5/5/2017 PROJECT MANAGER: K. RUTTER DRAWN BY: R. SHEDD DESIGNED BY: R. SHEDD CHECKED: S. GOODWIN GEORGIA TH-31 EASTBOUND 3 SHEET 104 OF 255						