



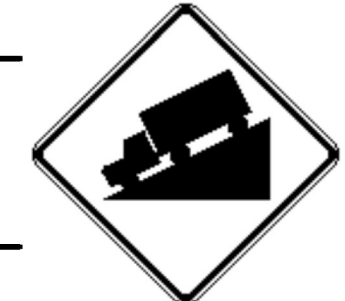




DIRECTION	MILEPOINT	LOCATION CODE (SHEET 4)	SIGN CODE	WIDTH (IN)	HEIGHT (IN)	SHEETING REMARKS	SIGN LEGEND	NEW SIGNS		EXISTING SIGNS			EXIST POST		NUMBER OF NEW POSTS	SQUARE STEEL (IN)			TUBULAR STEEL Ø (IN)				SIGN FRAME REQUIRED	REMARKS	SIGN DETAIL LOCATION				
								"A"	"B"	RETAIN	SALVAGE FROM	SALVAGE TO	REMOVE	RETAIN		REMOVE	1.75	2.00	2.50	FOUNDATION	3.00	3.50			4.00	5.00	SHSM	SIGN DETAIL SHEET #	STANDARD SHEET #
																	(LB / FT)				(LB / FT)								
<b>NB HYDE PARK TH-3</b>							FY-FLUORESCENT YELLOW FYG-FLUORESCENT YELLOW GREEN															"SHSM"-STANDARD HIGHWAY SIGNS AND MARKINGS BOOK							
NB	2.407	CD	D3-1				N HYDE PARK RD				1		X										5-14-18						
		CD	D3-1	68	12			5.67						2			10.00 X 10.50								11				
NB	2.407	D	R1-1				 STOP				1		X																
		D	R1-1	30	30			6.25						1			13.00 X						INSTALL IN SAME LOCATION AS EXISTING STOP SIGN	X					
NB	2.858	AB	D3-1				HYDE PARK ROAD				1		X																
		CD	D3-1				LANGDELL RD				1																		
		AB	D3-1	42	12			3.50						1			10.75 X								11				
NB	2.858	D	R1-1				 STOP				1		X																
		D	R1-1	30	30			6.25						1			13.00 X							X					
NB	2.929	A	W7-1	30	30			6.25						1			13.50 X						INSTALL 230 FT ± NORTH OF UTILITY POLE 8 1/2 AT MP 2.885	X					
NB	2.962	AB	D3-1				LANGDELL RD				1		X																
		CD	D3-1				HYDE PARK ROAD				1																		
		AB	D3-1	42	12			3.50						1			10.00 X								11				
NB	2.971	D	R1-1				 STOP				1		X																
		D	R1-1	30	30			6.25						1			13.50 X							X					
<b>SIGN SUMMARY SHEET</b>							<b>SHEET TOTALS</b>	37.67	0.00	0	0	0	8	0	0	8	94.25 <del>120.0</del>	0	0.0	0.0	0.0	0.0	PROJECT NAME: STATEWIDE-NORTH REGION PROJECT NUMBER: STP HRRR(22)						
VERMONT AGENCY OF TRANSPORTATION							<b>TOWN DIRECTIONAL TOTALS</b>	187.9	0.0	2	2	2	24	0	0	40	600.0	0		0.0			FILE NAME: z14k100tsshvdepark TH3 NB. PLOT DATE: 5/5/2017 PROJECT MANAGER: K. RUTTER DRAWN BY: R. SHEDD DESIGNED BY: R. SHEDD CHECKED: S. GOODWIN HYDE PARK TH-3 NORTHBOUND 2 SHEET 126 OF 255						