


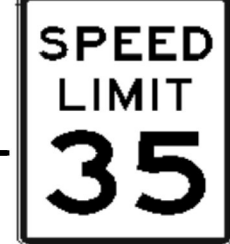

| DIRECTION | MILEPOINT | LOCATION CODE (SHEET 4) | SIGN CODE | WIDTH (IN) | HEIGHT (IN) | SHEETING REMARKS | SIGN LEGEND | NEW SIGNS | | EXISTING SIGNS | | | EXIST POST | | NUMBER OF NEW POSTS | SQUARE STEEL (IN) | | | TUBULAR STEEL Ø (IN) | | | | SIGN FRAME REQUIRED | REMARKS | SIGN DETAIL LOCATION | | | | |
|----------------------------------|-----------|-------------------------|-----------|------------|-------------|------------------|---|-----------|------|----------------|--------------|------------|------------|--------|---------------------|-------------------|--------------------------|------|----------------------|------------|----------------------------|---|--------------------------------------|------------------------------|----------------------|------|------|---------------------|------------------|
| | | | | | | | | "A" | "B" | RETAIN | SALVAGE FROM | SALVAGE TO | REMOVE | RETAIN | | REMOVE | 1.75 | 2.00 | 2.50 | FOUNDATION | 3.00 | 3.50 | | | 4.00 | 5.00 | SHSM | SIGN DETAIL SHEET # | STANDARD SHEET # |
| | | | | | | | | | | | | | | | | | (LB / FT) | | | | (LB / FT) | | | | | | | | |
| NB JAY TH-4 | | | | | | | FY-FLUORESCENT YELLOW FYG-FLUORESCENT YELLOW GREEN | | | | | | | | | | | | | | | "SHSM"-STANDARD HIGHWAY SIGNS AND MARKINGS BOOK | | | | | | | |
| NB | 0.480 | A | R2-1 | 24 | 30 | |  | 5.00 | | | | | | 1 | 12.50 X | | | | | | | 5-3-18 INSTALL 206 FT ± SOUTH OF REMOVED FIRE STATION SIGN | X | | | | | | |
| NB | 0.441 | A | | | | | FIRE STATION | | | | 1 | | | X | | | | | | | | | | | | | | | |
| | | A | W11-8 | 30 | 30 | |  | 6.25 | | | | | | 1 | 13.25 X | | | | | | | INSTALL IN SAME POSITION AS REMOVED SIGN | X | | | | | | |
| NB | 0.331 | A | S1-1 | 36 | 36 | FYG |  | 9.00 | | | | | | 2 | 13.25 X 13.00 | | | | | | | INSTALL 100 FT ± SOUTH OF UTILITY POLE 7/40 | X | | | | | | |
| | | A | S4-3P | 24 | 8 | FYG | | 1.33 | | | | | | | | | | | | | | | X | | | | | | |
| SIGN SUMMARY SHEET | | | | | | | SHEET TOTALS | 21.58 | 0.00 | 0 | 0 | 0 | 1 | 0 | 0 | 4 | 52.00 60.0 | 0 | 0.0 | 0.0 | 0.0 | 0.0 | PROJECT NAME: STATEWIDE-NORTH REGION | PROJECT NUMBER: STP HRRR(22) | | | | | |
| VERMONT AGENCY OF TRANSPORTATION | | | | | | | TOWN DIRECTIONAL TOTALS | 21.6 | 0.0 | 0 | 0 | 0 | 1 | 0 | 0 | 4 | 60.0 | 0 | | 0.0 | | FILE NAME: z14k100iavTH4 NB.xls | PLOT DATE: 5/5/2017 | | | | | | |
| | | | | | | | | | | | | | | | | | | | | | PROJECT MANAGER: K. RUTTER | DRAWN BY: J. FOWLER | | | | | | | |
| | | | | | | | | | | | | | | | | | | | | | DESIGNED BY: J. FOWLER | CHECKED: K. RUTTER | | | | | | | |
| | | | | | | | | | | | | | | | | | | | | | JAY TH-4 NORTHBOUND 1 | SHEET 135 OF 255 | | | | | | | |