




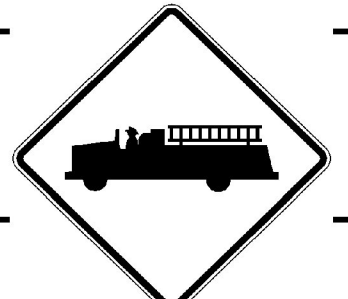


DIRECTION	MILEPOINT	LOCATION CODE (SHEET 4)	SIGN CODE	WIDTH (IN)	HEIGHT (IN)	SHEETING REMARKS	SIGN LEGEND	NEW SIGNS		EXISTING SIGNS			EXIST POST		NUMBER OF NEW POSTS	SQUARE STEEL (IN)			TUBULAR STEEL Ø (IN)				SIGN FRAME REQUIRED	REMARKS	SIGN DETAIL LOCATION				
								"A"	"B"	RETAIN	SALVAGE FROM	SALVAGE TO	REMOVE	RETAIN		REMOVE	1.75	2.00	2.50	FOUNDATION	3.00	3.50			4.00	5.00	SHSM	SIGN DETAIL SHEET #	STANDARD SHEET #
																	(LB / FT)				(LB / FT)								
SB JAY TH-4							FY-FLUORESCENT YELLOW FYG-FLUORESCENT YELLOW GREEN															"SHSM"-STANDARD HIGHWAY SIGNS AND MARKINGS BOOK							
SB	0.000	F	R2-1	24	30			5.00							1	14.50 X							5-3-18 INSTALL ACROSS FROM UTILITY POLE 10-61X1/7-35	X					
SB	0.044	F					SLOW CHILDREN				1																		
SB	0.113	F	S1-1	36	36	FYG		9.00							2	12.25 X 12.50							INSTALL 581 FT ± NORTH OF SCHOOL DRIVE.	X					
		F	S4-3P	24	8	FYG	SCHOOL	1.33																X					
SB	0.157	F	S4-3				SCHOOL PLAQUE				1																		
SB	0.280	G	R5-1	30	30			6.25							1	14.25 X							INSTALL 32 FT ± NORTH OF SCHOOLS EXIT DRIVEWAY	X					
		F	R6-1L	36	12			3.00															INSTALL BACK TO BACK	X					
		E	R6-1R	36	12			3.00															INSTALL BACK TO BACK	X					
SB	0.311	F	W11-8	30	30			6.25							1	13.50 X							INSTALL 95 FT ± SOUTH OF SCHOOL EXIT DRIVEWAY	X					
SB	0.502	F	VD2-1				JAY/ WESTFIELD ELEM SCHOOL			+	1	1	1	X	X	2	14.50 X 14.50						POSTS WERE DAMAGED SALVAGED SIGNS TO NEW POSTS						
SB	0.509	F	R1-1				STOP			+	1	1	1	X	X	2													
		G					REVOIR FLAT RD			+	1	1	1																
SIGN SUMMARY SHEET							SHEET TOTALS	33.83	0.00	3	3	3	5	0	0	4	116.25 60.0	0	0.0	0.0	0.0	0.0	PROJECT NAME: STATEWIDE-NORTH REGION						
VERMONT AGENCY OF TRANSPORTATION							TOWN DIRECTIONAL TOTALS	33.8	0.0	3	0	0	2	0	0	4	60.0	0					PROJECT NUMBER: STP HRRR(22)						
								SF	SF	EA	EA	EA	EA	EA	EA	EA	FT	EA	LB	LB	LB	FILE NAME: z14k100tssiav TH4 SB.xls	PLOT DATE: 5/5/2017						
																					PROJECT MANAGER: K. RUTTER	DRAWN BY: J.FOWLER							
																					DESIGNED BY: J. FOWLER	CHECKED: K. RUTTER							
																					JAY TH-4 SOUTHBOUND 1	SHEET 136 OF 255							