
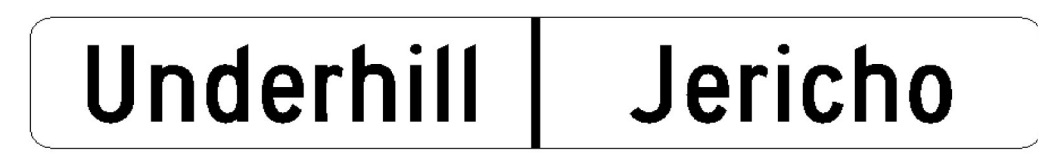


DIRECTION	MILEPOINT	LOCATION CODE (SHEET 4)	SIGN CODE	WIDTH (IN)	HEIGHT (IN)	SHEETING REMARKS	SIGN LEGEND	NEW SIGNS		EXISTING SIGNS			EXIST POST		NUMBER OF NEW POSTS	SQUARE STEEL (IN)			TUBULAR STEEL Ø (IN)				SIGN FRAME REQUIRED	REMARKS	SIGN DETAIL LOCATION				
								"A"	"B"	RETAIN	SALVAGE FROM	SALVAGE TO	REMOVE	RETAIN		REMOVE	1.75	2.00	2.50	FOUNDATION	3.00	3.50			4.00	5.00	SHSM	SIGN DETAIL SHEET #	STANDARD SHEET #
																	(LB / FT)				(LB / FT)								
EB JERICHO TH-5							FY-FLUORESCENT YELLOW FYG-FLUORESCENT YELLOW GREEN															"SHSM"-STANDARD HIGHWAY SIGNS AND MARKINGS BOOK							
EB	0.305	A	W11-2				PEDESTRIAN			1			X																
EB	0.352	A												1															
		A		36	36									2										26					
EB	0.445	C	VD-024				UNDERHILL JERICHO							1															
		C	VD-024	72	10									2											T-94				
SIGN SUMMARY SHEET							SHEET TOTALS	14.00	0.00	1	0	0	2	0	0	4	38.75	0	0.0	0.0	0.0	0.0	PROJECT NAME: STATEWIDE-NORTH REGION						
VERMONT AGENCY OF TRANSPORTATION							TOWN DIRECTIONAL TOTALS	SF	SF	EA	EA	EA	EA	EA	EA	EA	FT	EA	LB	LB	LB	LB	PROJECT NUMBER: STP HRRR(22)						
								17.0	0.0	14	0	0	3	0	0	5	75.0	0		0.0			FILE NAME: z14k100tssiericho TH5 EB.xls						
																						PLOT DATE: 5/5/2017							
																						DRAWN BY: R. SHEDD							
																						CHECKED: S. GOODWIN							
																						SHEET 138 OF 255							

SIGN WILL NOT WORK WITH 2 POSTS

5-5-18

HINGED / FOLDABLE