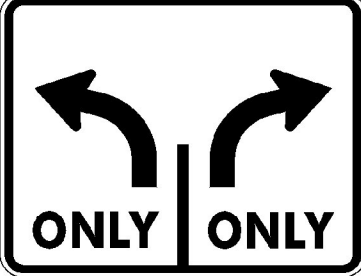



DIRECTION	MILEPOINT	LOCATION CODE (SHEET 4)	SIGN CODE	WIDTH (IN)	HEIGHT (IN)	SHEETING REMARKS	SIGN LEGEND	NEW SIGNS		EXISTING SIGNS			EXIST POST		NUMBER OF NEW POSTS	SQUARE STEEL (IN)			TUBULAR STEEL Ø (IN)				SIGN FRAME REQUIRED	REMARKS	SIGN DETAIL LOCATION				
								"A"	"B"	RETAIN	SALVAGE FROM	SALVAGE TO	REMOVE	RETAIN		REMOVE	1.75	2.00	2.50	FOUNDATION	3.00	3.50			4.00	5.00	SHSM	SIGN DETAIL SHEET #	STANDARD SHEET #
																	(LB / FT)				(LB / FT)								
WB JERICHO TH-5							FY-FLUORESCENT YELLOW FYG-FLUORESCENT YELLOW GREEN															"SHSM"-STANDARD HIGHWAY SIGNS AND MARKINGS BOOK							
WB	0.027	F	VR-925	36	30			7.50						1	13.50 X								INSTALL 85 FT ± EAST OF EXISTING SIGN AT MP 0.011			E-145A			
WB	0.011	F	R1-1							1																			
		F	R1-1	30	30		SIGN NOT REPLACED PUT IN NEW LAST YEAR	6.25								X									X				
SIGN SUMMARY SHEET							SHEET TOTALS	7.50 13.75	0.00	0	0	0	0	0	2	13.50 30.0	0	0.0	0.0	0.0	0.0	0.0	0.0	PROJECT NAME: STATEWIDE-NORTH REGION PROJECT NUMBER: STP HRRR(22)					
VERMONT AGENCY OF TRANSPORTATION							TOWN DIRECTIONAL TOTALS	57.0	0.0	10	0	0	9	0	0	7	105.0	0		0.0				FILE NAME: z14k100tssiericho TH5 WB.xl PROJECT MANAGER: K. RUTTER DESIGNED BY: R. SHEDD JERICHO TH-5 WESTBOUND 3	PLOT DATE: 5/5/2017 DRAWN BY: R. SHEDD CHECKED: S. GOODWIN SHEET 141 OF 255				