










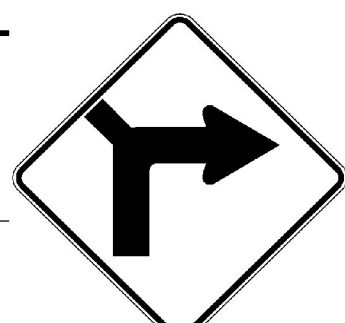

| DIRECTION | MILEPOINT | LOCATION CODE (SHEET 4) | SIGN CODE | WIDTH (IN) | HEIGHT (IN) | SHEETING REMARKS | SIGN LEGEND | NEW SIGNS | | EXISTING SIGNS | | | EXIST POST | | NUMBER OF NEW POSTS | SQUARE STEEL (IN) | | | TUBULAR STEEL Ø (IN) | | | | SIGN FRAME REQUIRED | REMARKS | SIGN DETAIL LOCATION | | | | |
|----------------------------------|---------------|-------------------------|-----------|------------|-------------|------------------|---|-----------|------|----------------|--------------|------------|------------|--------|---------------------|-------------------|-----------------|------|----------------------|------------|-----------|---|--|---------|----------------------|------|------|---------------------|------------------|
| | | | | | | | | "A" | "B" | RETAIN | SALVAGE FROM | SALVAGE TO | REMOVE | RETAIN | | REMOVE | 1.75 | 2.00 | 2.50 | FOUNDATION | 3.00 | 3.50 | | | 4.00 | 5.00 | SHSM | SIGN DETAIL SHEET # | STANDARD SHEET # |
| | | | | | | | | | | | | | | | | | (LB / FT) | | | | (LB / FT) | | | | | | | | |
| SB MORRISTOWN TH-6 | | | | | | | FY-FLUORESCENT YELLOW FYG-FLUORESCENT YELLOW GREEN | | | | | | | | | | | | | | | "SHSM"-STANDARD HIGHWAY SIGNS AND MARKINGS BOOK | | | | | | | |
| SB | 2.442 - 2.426 | F | | 6 | 8 | | INSTALL (3) NEW DELINEATOR POSTS | | | | | | | | | | | | | | | 5-17-18 INSTALL (6) NEW TYPE II 6"x8" WHITE DELINEATORS BACK TO BACK ON 3 NEW POSTS; INSTALL THE FIRST POST AT MP 2.442 THEN EVERY 40 FT ± SEE SHEET 9 | | | | | | | |
| SB | 2.205 | F | W1-1MdR | 36 | 36 | FY |  | 9.00 | | | | | | 2 | 18.25 X 18.25 | | | | | | | TYPE IX FLUORESCENT YELLOW SHEETING | | 27 | | | | | |
| | | F | W16-8p | 30 | 8 | FY |  | 1.67 | | | | | | | | | | | | | | TYPE IX FLUORESCENT YELLOW SHEETING | | 13 | | | | | |
| | | F | W13-1p | 18 | 18 | FY |  | 2.25 | | | | | | | | | | | | | | TYPE IX FLUORESCENT YELLOW SHEETING. INSTALL ON LEFT POST | X | | | | | | |
| SB | 2.073 | F | R2-1 | | | |  SPEED LIMIT 40 | | | | | 1 | | X | | | | | | | | 5-16-18 | | | | | | | |
| | | F | R2-1 | 24 | 30 | | | 5.00 | | | | | | 1 | 13.50 X | | | | | | | | X | | | | | | |
| SB | 2.026 | F | W5-2 | 36 | 36 | |  | 9.00 | | | | | | 2 | 15.50 X 15.75 | | | | | | | INSTALL 250 FT ± SOUTH OF EXISTING SIGN AT MP 2.073 | X | | | | | | |
| | | F | W13-1p | 18 | 18 | |  | 2.25 | | | | | | | | | | | | | | INSTALL ON LEFT POST | X | | | | | | |
| SB | 1.972 | F | OM3-R | 12 | 36 | |  | 3.00 | | | | | | 1 | 10.75 X | | | | | | | INSTALL ON NORTH SIDE OF BRIDGE | X | | | | | | |
| SB | 1.964 | E | OM3-L | 12 | 36 | |  | 3.00 | | | | | | 1 | 10.50 X | | | | | | | INSTALL ON SOUTH SIDE OF BRIDGE | X | | | | | | |
| SB | 1.481 | F | W11-1 | 30 | 30 | |  | 6.25 | | | | | | 1 | 17.75 X | | | | | | | INSTALL 440 FT ± NORTH OF EXISTING SIGN AT MP 1.398 | X | | | | | | |
| | | F | | 18 | 24 | |  | 3.00 | | | | | | | | | | | | | | | | 25 | | | | | |
| SB | 1.398 | EF | D3-1 | | | | STANCLIFF RD | | | | | 1 | | X | | | | | | | | | | | | | | | |
| | | EF | D3-1 | 42 | 12 | |  | 3.50 | | | | | | 1 | 12.50 X | | | | | | | 3 DEL. | | | 13 | | | | |
| SIGN SUMMARY SHEET | | | | | | | SHEET TOTALS | 47.92 | 0.00 | 0 | 0 | 0 | 2 | 0 | 0 | 9 | 132.75 135.0 | 0 | 0.0 | 0.0 | 0.0 | 0.0 | PROJECT NAME: STATEWIDE-NORTH REGION PROJECT NUMBER: STP HRRR(22) | | | | | | |
| VERMONT AGENCY OF TRANSPORTATION | | | | | | | TOWN DIRECTIONAL TOTALS | 264.2 | 0.0 | 1 | 0 | 0 | 43 | 0 | 0 | 51 | 765.0 | 0 | | | 0.0 | | FILE NAME: z14k100tssmorrystown TH6 PROJECT MANAGER: K. RUTTER DESIGNED BY: R. SHEDD MORRISTOWN TH-6 SOUTHBOUND 6 | | | | | | |
| | | | | | | | | | | | | | | | | | | | | | | PLOT DATE: 5/5/2017 DRAWN BY: R. SHEDD CHECKED: S. GOODWIN SHEET 155 OF 255 | | | | | | | |