







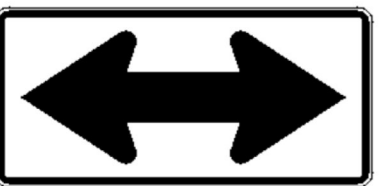


DIRECTION	MILEPOINT	LOCATION CODE (SHEET 4)	SIGN CODE	WIDTH (IN)	HEIGHT (IN)	SHEETING REMARKS	SIGN LEGEND	NEW SIGNS		EXISTING SIGNS			EXIST POST		NUMBER OF NEW POSTS	SQUARE STEEL (IN)			TUBULAR STEEL Ø (IN)				SIGN FRAME REQUIRED	REMARKS	SIGN DETAIL LOCATION				
								"A"	"B"	RETAIN	SALVAGE FROM	SALVAGE TO	REMOVE	RETAIN		REMOVE	1.75	2.00	2.50	FOUNDATION	3.00	3.50			4.00	5.00	SHSM	SIGN DETAIL SHEET #	STANDARD SHEET #
																	(LB / FT)				(LB / FT)								
<b>SB ORANGE TH-1</b>							FY-FLUORESCENT YELLOW FYG-FLUORESCENT YELLOW GREEN															"SHSM"-STANDARD HIGHWAY SIGNS AND MARKINGS BOOK							
SB	3.574	F	R2-1				SPEED LIMIT 35																6-18-18						
		F	W9-12				 SLOW CHILDREN AT PLAY																						
		F	R2-1	24	30																			X					
SB	3.131	F	VW-133R	30	30																					T-81			
SB	2.767	F	W2-3L	30	30																		INSTALL 315 FT ± NORTH OF EXISTING SIGN AT MP 2.707	X					
		F	W16-8p	24	8																					14			
SB	2.707	EF	D3-1				BISSON RD																6-8-18						
		E	R2-1				 SPEED LIMIT 35																MOUNT BISSON RD PERP ON TOP OF SPEED LIMIT 35			14			
		EF	D3-1	42	12																			X					
SB	2.689	H	W3-1	30	30																		INSTALL 300 FT ± FROM EXISTING STOP SIGN ON BISSON RD	X					
SB	2.689	H	R1-1																										
		H	R1-1	30	30																			X					
SB	2.473	G	R1-1				STOP																						
		G	W1-7	48	24																			X					
<b>SIGN SUMMARY SHEET</b>							SHEET TOTALS	47.83	0.00	0	0	0	6	0	0	8	12.50	X							PROJECT NAME: STATEWIDE-SOUTH REGION				
								SF	SF	EA	EA	EA	EA	EA	EA	EA	FT		EA	LB	LB	LB	LB	PROJECT NUMBER: STP HRRR(22)					
VERMONT AGENCY OF TRANSPORTATION							TOWN DIRECTIONAL TOTALS	172.5	0.0	0	1	1	27	0	0	34	510.0		0						FILE NAME: z14k100tssorange TH1 SB.xls PLOT DATE: 5/5/2017				
																							PROJECT MANAGER: K. RUTTER DRAWN BY: R. SHEDD						
																							DESIGNED BY: R. SHEDD CHECKED: S. GOODWIN						
																							ORANGE TH-1 SOUTHBOUND 2 SHEET 163 OF 255						