

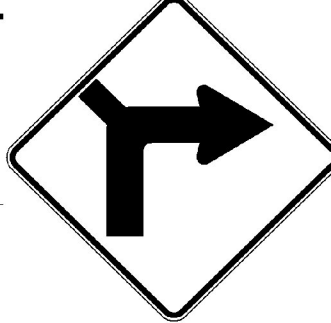





DIRECTION	MILEPOINT	LOCATION CODE (SHEET 4)	SIGN CODE	WIDTH (IN)	HEIGHT (IN)	SHEETING REMARKS	SIGN LEGEND	NEW SIGNS		EXISTING SIGNS			EXIST POST		NUMBER OF NEW POSTS	SQUARE STEEL (IN)			TUBULAR STEEL Ø (IN)				SIGN FRAME REQUIRED	REMARKS	SIGN DETAIL LOCATION				
								"A"	"B"	RETAIN	SALVAGE FROM	SALVAGE TO	REMOVE	RETAIN		REMOVE	1.75	2.00	2.50	FOUNDATION	3.00	3.50			4.00	5.00	SHSM	SIGN DETAIL SHEET #	STANDARD SHEET #
																	(LB / FT)				(LB / FT)								
NB PANTON JERSEY ST							FY-FLUORESCENT YELLOW FYG-FLUORESCENT YELLOW GREEN															"SHSM"-STANDARD HIGHWAY SIGNS AND MARKINGS BOOK							
NB	0.000	A	W3-1	30	30			6.25						1	15.25 X								10-18-18 INSTALL ACROSS FROM UTILITY POLE 21/2/30F2	X					
NB	0.091	A	R1-1				STOP			2 +																			
		A	R1-1				STOP				2 +			1	10.75 X														
NB	0.099	C	W1-6	48	24			8.00						2	9.00 X 9.00								10-24-18 INSTALL 40 FT ± NORTH OF EXISTING SIGN AT MP 0.091 FACING PEASE RD	X					
NB	0.216	A	R2-1				SPEED LIMIT 45			1			1																
NB	0.591	A	W1-1MdR	36	36			9.00						2	13.25 X 13.25									INSTALL 145 FT ± NORTH OF EXISTING SIGN AT MP 0.564		27			
		A	W16-8p	30	8			1.67																	15				
		A	W13-1p	18	18			2.25																INSTALL ON LEFT POST	X				
NB	0.613	A	W1-1R				RIGHT TURN ARROW					1																	
		A	W13-1p				25 M.P.H. (PLAQUE)					1																	
NB	0.623	A					PARK AND RIDE SIGN			1													10-18-18						
NB	0.657	A	VR-615	30	36			7.50						1	14.50 X									INSTALL 15 FT ± SOUTH OF UTILITY POLE 1/3106		25			
NB	0.681	D					LAKE CHAMPLAIN MARITIME MUSEUM					1												SIGN IS LOCATED ON UTILITY POLE IN NORTHEAST CORNER OF PANTON RD AND JERSEY ST INTERSECTION					
SIGN SUMMARY SHEET							SHEET TOTALS	34.67	0.00	2	1	2 +	5 +	1	0	7	85.00 105.0		0	0.0	0.0	0.0	0.0	PROJECT NAME: STATEWIDE-NORTH REGION	PROJECT NUMBER: STP HRRR(22)				
VERMONT AGENCY OF TRANSPORTATION							TOWN DIRECTIONAL TOTALS	55.6	0.0	2	1	1	8	1	0	11	165.0		0		0.0			FILE NAME: z14k100tsspanton TH1 NB.xls	PLOT DATE: 5/5/2017	DRAWN BY: R. SHEDD			
																						DESIGNED BY: R. SHEDD	CHECKED: S. GOODWIN	SHEET 166 OF 255					