
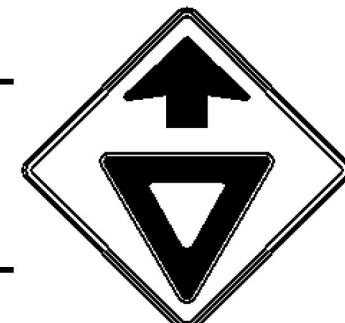



DIRECTION	MILEPOINT	LOCATION CODE (SHEET 4)	SIGN CODE	WIDTH (IN)	HEIGHT (IN)	SHEETING REMARKS	SIGN LEGEND	NEW SIGNS		EXISTING SIGNS			EXIST POST		NUMBER OF NEW POSTS	SQUARE STEEL (IN)			TUBULAR STEEL Ø (IN)				SIGN FRAME REQUIRED	REMARKS	SIGN DETAIL LOCATION				
								"A"	"B"	RETAIN	SALVAGE FROM	SALVAGE TO	REMOVE	RETAIN		REMOVE	1.75	2.00	2.50	FOUNDATION	3.00	3.50			4.00	5.00	SHSM	SIGN DETAIL SHEET #	STANDARD SHEET #
																	(LB / FT)				(LB / FT)								
<b>SB PANTON JERSEY ST</b>							FY-FLUORESCENT YELLOW FYG-FLUORESCENT YELLOW GREEN															"SHSM"-STANDARD HIGHWAY SIGNS AND MARKINGS BOOK							
SB	1.222	F	W3-1	30	30			6.25						1	14.25 X								INSTALL ACROSS FROM UTILITY POLE GMP/2/3 10-20-17	X					
SB	1.155	F	R1-1				STOP			1																			
		F	R1-1				STOP				1			2	13.00 X 13.00														
SB	1.152	HG	D3-1	42	12		<b>Jersey st</b>	3.50						1	11.00 X								INSTALL PERP TO BUTTON BAY RD		15				
SB	1.152	E					LAKE CHAMPLAIN MARITIME MUSEUM																						
SB	1.152	EF	D3-1				BUTTON BAY RD																INSTALL PERP TO JERSEY ST						
		EF	D3-1	60	12		<b>Button Bay Rd</b>	5.00						2	11.50 X 11.00										15				
SB	0.772	F	W1-1L				HARD LEFT																						
		F	W13-1p				25 M.P.H. (PLAQUE)																						
SB	0.746	F	W3-2	30	30			6.25						1	13.50 X								INSTALL 140 FT ± SOUTH OF EXISTING SIGN AT MP 0.772	X					
SB	0.709	G	R2-1				SPEED LIMIT 35			1																			
SB	0.705	H	R1-1	30	30			6.25						1	13.25 X										X				
SB	0.705	EF	D3-1	68	12		<b>Adams Ferry Rd</b>	5.67						2	11.25 X 11.00											15			
SB	0.684	F	VD-503				CHAMPLAIN BIKEWAY				1																		
		F	M6-1				LEFT ARROW PLAQUE				1																		
<b>SIGN SUMMARY SHEET</b>							SHEET TOTALS	32.92	0.00	1	3	1	7	0	0	10	122.75 150.0	0	0.0	0.0	0.0	0.0		PROJECT NAME: STATEWIDE-NORTH REGION PROJECT NUMBER: STP HRRR(22)					
VERMONT AGENCY OF TRANSPORTATION							TOWN DIRECTIONAL TOTALS	71.2	0.0	1	3	3	13	0	0	18	270.0	0		0.0				FILE NAME: z14k100tsspanton TH1 SB.xls PLOT DATE: 5/5/2017 PROJECT MANAGER: K. RUTTER DRAWN BY: R. SHEDD DESIGNED BY: R. SHEDD CHECKED: S. GOODWIN PANTON JERSEY ST SOUTHBOUND 1 SHEET 168 OF 255					