

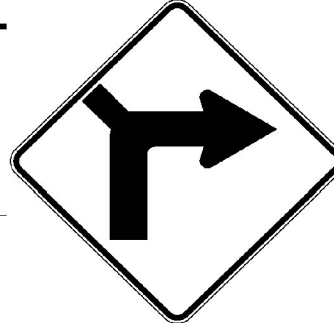
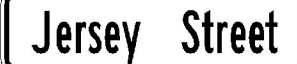

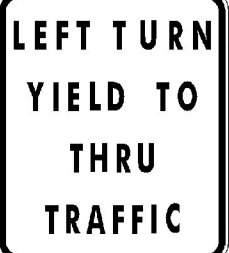



DIRECTION	MILEPOINT	LOCATION CODE (SHEET 4)	SIGN CODE	WIDTH (IN)	HEIGHT (IN)	SHEETING REMARKS	SIGN LEGEND	NEW SIGNS		EXISTING SIGNS			EXIST POST		NUMBER OF NEW POSTS	SQUARE STEEL (IN)			TUBULAR STEEL Ø (IN)				SIGN FRAME REQUIRED	REMARKS	SIGN DETAIL LOCATION				
								"A"	"B"	RETAIN	SALVAGE FROM	SALVAGE TO	REMOVE	RETAIN		REMOVE	1.75	2.00	2.50	FOUNDATION	3.00	3.50			4.00	5.00	SHSM	SIGN DETAIL SHEET #	STANDARD SHEET #
																	(LB / FT)				(LB / FT)								
<b>SB PANTON JERSEY ST</b>							FY-FLUORESCENT YELLOW FYG-FLUORESCENT YELLOW GREEN															"SHSM"-STANDARD HIGHWAY SIGNS AND MARKINGS BOOK							
SB	0.681	GH	D3-1				JERSEY STREET																10-18-17						
		F	R1-2				YIELD																						
		GH	D3-1	42	12			3.50															MOUNT JERSEY ST PERP ON YIELD SIGN		15				
		F	R1-2	36	36			3.90															36" x 36" x 36"	X					
SB	0.665	F	VD-503				CHAMPLAIN BIKEWAY				1												10-20-17						
		F	M6-1				LEFT ARROW PLAQUE				1												INSTALL 100 FT ± SOUTH FROM EXISTING LOCATION						
SB	0.191	F	W1-10R				MODIFIED RIGHT CURVE																10-24-17						
		F	W13-1p				20 M.P.H. (PLAQUE)				1																		
SB	0.161	F	W1-1MdR	36	36			9.00															10-20-17						
		F	W16-8p	30	8			1.67																					
		F	W13-1p	18	18			2.25															INSTALL ON LEFT POST	X					
SB	0.128	F		24	30			5.00															10-20-17						
		F																											
SB	0.086	F	W1-6				LARGE ARROW																10-18-17						
		F	W1-6	48	24			8.00																					
<b>SIGN SUMMARY SHEET</b>							SHEET TOTALS	33.32	0.00	0	0	2	5	0	0	7	89.25						PROJECT NAME: STATEWIDE-NORTH REGION						
								SF	SF	EA	EA	EA	EA	EA	EA	EA	FT						PROJECT NUMBER: STP HRRR(22)						
VERMONT AGENCY OF TRANSPORTATION							TOWN DIRECTIONAL TOTALS	71.2	0.0	1	3	3	13	0	0	18	270.0						FILE NAME: z14k100tsspanton TH1 SB.xls	PLOT DATE: 5/5/2017					
																							PROJECT MANAGER: K. RUTTER	DRAWN BY: R. SHEDD					
																							DESIGNED BY: R. SHEDD	CHECKED: S. GOODWIN					
																							PANTON JERSEY ST SOUTHBOUND 2	SHEET 169 OF 255					