


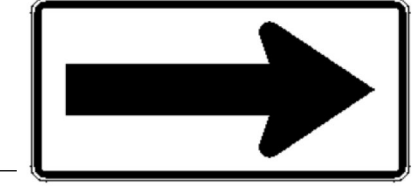


DIRECTION	MILEPOINT	LOCATION CODE (SHEET 4)	SIGN CODE	WIDTH (IN)	HEIGHT (IN)	SHEETING REMARKS	SIGN LEGEND	NEW SIGNS		EXISTING SIGNS			EXIST POST		NUMBER OF NEW POSTS	SQUARE STEEL (IN)			TUBULAR STEEL Ø (IN)				SIGN FRAME REQUIRED	REMARKS	SIGN DETAIL LOCATION				
								"A"	"B"	RETAIN	SALVAGE FROM	SALVAGE TO	REMOVE	RETAIN		REMOVE	1.75	2.00	2.50	FOUNDATION	3.00	3.50			4.00	5.00	SHSM	SIGN DETAIL SHEET #	STANDARD SHEET #
																	(LB / FT)				(LB / FT)								
WB ROXBURY TH-1							FY-FLUORESCENT YELLOW FYG-FLUORESCENT YELLOW GREEN															"SHSM"-STANDARD HIGHWAY SIGNS AND MARKINGS BOOK							
WB	1.460	F	W8-3				PAVEMENT ENDS			1																			
WB	1.002	F	R2-1				SPEED LIMIT 35			1																			
WB	0.582	F	D3-1				SHAW RD						1																
		F	D3-1	40	12			3.33						1	13.75	X							5-24-18		18				
WB	0.536	F	R2-1				SPEED LIMIT 35			1																			
WB	0.276	F	W1-4L	30	30			6.25						1	10.75	X							INSTALL 1375 FT ± WEST OF RETAINED SL-35 AT MP 0.536	X					
WB	0.218	F	W1-6	48	24			8.00						2	13.75	X							5-23-18 INSTALL 305 FT ± WEST OF PROPOSED SIGN AT MP 0.276	X					
WB	0.189	E	W1-6	48	24			8.00						2	12.75	X							INSTALL FACING EB TRAFFIC INSTALL 155 FT ± WEST OF PROPOSED SIGN AT MP 0.218	X					
SIGN SUMMARY SHEET							SHEET TOTALS	25.58	0.00	3	0	0	1	0	0	6	77.25	90.0	0	0.0	0.0	0.0	0.0	PROJECT NAME: STATEWIDE-NORTH REGION	PROJECT NUMBER: STP HRRR(22)				
VERMONT AGENCY OF TRANSPORTATION							TOWN DIRECTIONAL TOTALS	98.9	0.0	3	1	1	16	0	0	20	300.0	0	0.0	0.0	0.0	0.0	FILE NAME: z14k100tssroxburv TH1 WB.x	PLOT DATE: 5/5/2017	DRAWN BY: R. SHEDD				
																						DESIGNED BY: R. SHEDD	CHECKED: S. GOODWIN	SHEET 192 OF 255					