

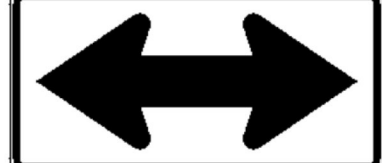



DIRECTION	MILEPOINT	LOCATION CODE (SHEET 4)	SIGN CODE	WIDTH (IN)	HEIGHT (IN)	SHEETING REMARKS	SIGN LEGEND	NEW SIGNS		EXISTING SIGNS			EXIST POST		NUMBER OF NEW POSTS	SQUARE STEEL (IN)			TUBULAR STEEL Ø (IN)				SIGN FRAME REQUIRED	REMARKS	SIGN DETAIL LOCATION				
								"A"	"B"	RETAIN	SALVAGE FROM	SALVAGE TO	REMOVE	RETAIN		REMOVE	1.75	2.00	2.50	FOUNDATION	3.00	3.50			4.00	5.00	SHSM	SIGN DETAIL SHEET #	STANDARD SHEET #
																	(LB / FT)				(LB / FT)								
NB SHELBURNE TH-5							FY-FLUORESCENT YELLOW FYG-FLUORESCENT YELLOW GREEN															"SHSM"-STANDARD HIGHWAY SIGNS AND MARKINGS BOOK							
NB	0.151	A	W11-7				 EQUESTRIAN WARNING					1		X															
		A	W11-7	30	30			6.25							1		14.75	X								X			
NB	0.722	A	R2-1				 SPEED LIMIT 40					1		X															
		A	R2-1	24	30			5.00							1		14.50	X								X			
NB	1.260	C	W1-7				TWO DIRECTION LARGE ARROW					1		X															
		C	R1-1				STOP					1																	
		C	W1-7	48	24			8.00							2		13.50	X								X			
NB	1.281	A	R2-1				SPEED LIMIT 40					1		X															
		A	VR-017				LEGAL LOAD LIMIT 24,000 POUNDS					1																	
		A	VR-017	24	30			5.00							1		16.00	X								T-70			
		A	R2-1	24	30		 SPEED LIMIT 40	5.00																		X			
SIGN SUMMARY SHEET							SHEET TOTALS	29.25	0.00	0	0	0	6	0	0	5	72.25	0	0.0	0.0	0.0	0.0	PROJECT NAME: STATEWIDE-NORTH REGION						
								SF	SF	EA	EA	EA	EA	EA	EA	EA	FT	EA	LB	LB	LB	LB	PROJECT NUMBER: STP HRRR(22)						
VERMONT AGENCY OF TRANSPORTATION							TOWN DIRECTIONAL TOTALS	48.3	0.0	0	2	2	14	0	0	8	120.0	0				0.0	FILE NAME: z14k100tssshelburne TH5 NE PLOT DATE: 5/5/2017						
																						PROJECT MANAGER: K. RUTTER DRAWN BY: R. SHEDD							
																						DESIGNED BY: R. SHEDD CHECKED: S. GOODWIN							
																						SHELBURNE TH-5 NORTHBOUND 2 SHEET 194 OF 255							

4-30-18

INSTALL IN SAME LOCATION AS EXISTING ACROSS FROM BISHOP RD ON DORSET ST

SLIP BASE REQUIRED SEE SHEET 9

T-70