
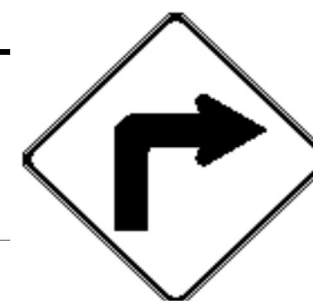






DIRECTION	MILEPOINT	LOCATION CODE (SHEET 4)	SIGN CODE	WIDTH (IN)	HEIGHT (IN)	SHEETING REMARKS	SIGN LEGEND	NEW SIGNS		EXISTING SIGNS			EXIST POST		NUMBER OF NEW POSTS	SQUARE STEEL (IN)			TUBULAR STEEL Ø (IN)				SIGN FRAME REQUIRED	REMARKS	SIGN DETAIL LOCATION				
								"A"	"B"	RETAIN	SALVAGE FROM	SALVAGE TO	REMOVE	RETAIN		REMOVE	1.75	2.00	2.50	FOUNDATION	3.00	3.50			4.00	5.00	SHSM	SIGN DETAIL SHEET #	STANDARD SHEET #
																	(LB / FT)				(LB / FT)								
<b>NB SOUTH HERO TH-13</b>							FY-FLUORESCENT YELLOW FYG-FLUORESCENT YELLOW GREEN															"SHSM"-STANDARD HIGHWAY SIGNS AND MARKINGS BOOK							
NB	4.851	D	W3-1	30	30			6.25						1	13.50 X								INSTALL SIGN 700 FT UP HILL ON EAGLE CAMP RD, DIRECTLY ACROSS FROM UTILITY POLE 71/4/2	X					
NB	4.960	A	W1-1R	30	30			6.25						1	15.60 X								INSTALL ACROSS FROM UTILITY POLE NET/92/12	X					
		A	W13-1p	18	18			2.25																X					
NB	5.060	A	R2-1									1		X									EXACT MP NOT GIVEN, ESTIMATED. USE EXISTING SL-35 FOR POSITION REFERENCE						
		A	R2-1	24	30			5.00						1	15.25 X								REPLACE EXISTING SPEED LIMIT SIGN IN SAME LOCATION	X					
NB	5.481	A	W3-1	30	30			6.25						1	14.00 X										X				
<b>SIGN SUMMARY SHEET</b>							SHEET TOTALS	26.00	0.00	0	0	0	1	0	0	4	58.25 <del>60.0</del>	0	0.0	0.0	0.0	0.0		PROJECT NAME: STATEWIDE-NORTH REGION					
VERMONT AGENCY OF TRANSPORTATION							TOWN DIRECTIONAL TOTALS	228.9	0.0	0	0	0	30	0	0	45	675.0	0		0.0			PROJECT NUMBER: STP HRRR(22)						
																						FILE NAME: z14k100tsssouthheroTH13 N	PLOT DATE: 5/5/2017						
																						PROJECT MANAGER: K. RUTTER	DRAWN BY: R. SHEDD						
																						DESIGNED BY: R. SHEDD	CHECKED: S. GOODWIN						
																						SOUTH HERO TH-13 NORTHBOUND 6	SHEET 202	OF 255					