
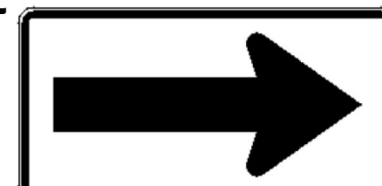
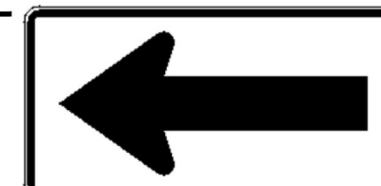






DIRECTION	MILEPOINT	LOCATION CODE (SHEET 4)	SIGN CODE	WIDTH (IN)	HEIGHT (IN)	SHEETING REMARKS	SIGN LEGEND	NEW SIGNS		EXISTING SIGNS			EXIST POST		NUMBER OF NEW POSTS	SQUARE STEEL (IN)			TUBULAR STEEL Ø (IN)				SIGN FRAME REQUIRED	REMARKS	SIGN DETAIL LOCATION				
								"A"	"B"	RETAIN	SALVAGE FROM	SALVAGE TO	REMOVE	RETAIN		REMOVE	1.75	2.00	2.50	FOUNDATION	3.00	3.50			4.00	5.00	SHSM	SIGN DETAIL SHEET #	STANDARD SHEET #
																	(LB / FT)				(LB / FT)								
SB SOUTH HERO TH-13							FY-FLUORESCENT YELLOW FYG-FLUORESCENT YELLOW GREEN															"SHSM"-STANDARD HIGHWAY SIGNS AND MARKINGS BOOK							
SB	5.557	GH	D3-1				WEST SHORE RD																4-21-18						
		GH	D3-1	60	12			5.00																	19				
SB	5.552	F	W1-6	48	24			8.00																X					
SB	5.551	E	W1-6	48	24			8.00																X					
SB	5.552	E	W1-8				RIGHT CHEVRON																						
SB	5.548	F	R1-2				YIELD																						
		F	W1-8				RIGHT CHEVRON																						
		E	W1-8				LEFT CHEVRON																						
		F	W1-6	48	24			8.00															REPLACE CHEVRONS ON BRACKET POST	X					
SB	5.547	E	W1-6	48	24			8.00															4-27-18	X					
SB	5.539	F	VR-017				LLL 24,000 LBS																						
		F	R2-1				SPEED LIMIT 35																						
								5.00																					
SB	5.519	F	VR-017	24	30		SPEED LIMIT 35	5.00															INSTALL 105 FT ± SOUTH OF EXISTING SIGN AT MP 5.539	X					
		F	R2-1	24	30			5.00																X					
SB	5.060	F	R2-1				SPEED LIMIT 25																EXACT MP NOT GIVEN, ESTIMATED. USE EXISTING SL-35 FOR POSITION REFERENCE						
SIGN SUMMARY SHEET							SHEET TOTALS	47.00	0.00	0	0	0	8	0	0	11	145.25							PROJECT NAME: STATEWIDE-NORTH REGION					
								SF	SF	EA	EA	EA	EA	EA	EA	EA	FT							PROJECT NUMBER: STP HRRR(22)					
VERMONT AGENCY OF TRANSPORTATION							TOWN DIRECTIONAL TOTALS	372.2	0.0	0	0	0	50	0	0	80	1200.0							FILE NAME: z14k100tsssouthhero TH13 S	PLOT DATE: 5/5/2017				
																							PROJECT MANAGER: K. RUTTER	DRAWN BY: R. SHEDD					
																							DESIGNED BY: R. SHEDD	CHECKED: S. GOODWIN					
																							SOUTH HERO TH-13 SOUTHBOUND 1	SHEET 203 OF 255					