
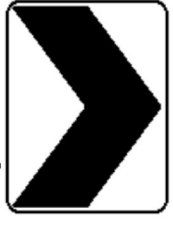

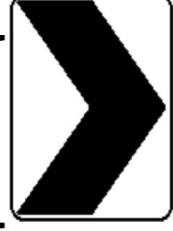


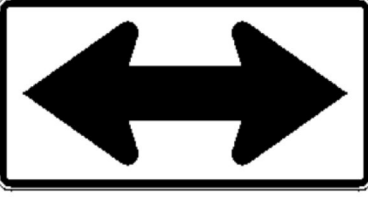




DIRECTION	MILEPOINT	LOCATION CODE (SHEET 4)	SIGN CODE	WIDTH (IN)	HEIGHT (IN)	SHEETING REMARKS	SIGN LEGEND	NEW SIGNS		EXISTING SIGNS			EXIST POST		NUMBER OF NEW POSTS	SQUARE STEEL (IN)			TUBULAR STEEL Ø (IN)				SIGN FRAME REQUIRED	REMARKS	SIGN DETAIL LOCATION				
								"A"	"B"	RETAIN	SALVAGE FROM	SALVAGE TO	REMOVE	RETAIN		REMOVE	1.75	2.00	2.50	FOUNDATION	3.00	3.50			4.00	5.00	SHSM	SIGN DETAIL SHEET #	STANDARD SHEET #
																	(LB / FT)				(LB / FT)								
SB SOUTH HERO TH-13							FY-FLUORESCENT YELLOW FYG-FLUORESCENT YELLOW GREEN															"SHSM"-STANDARD HIGHWAY SIGNS AND MARKINGS BOOK							
SB	3.777	F	W1-8				LEFT CHEVRON															4-25-18							
		E	W1-8				RIGHT CHEVRON																						
SB	3.777	F	W1-8	24	30	FY		5.00														14.50 X			X	TYPE IX FLUORESCENT YELLOW SHEETING			
SB	3.776	E	W1-8	24	30	FY		5.00														14.50 X			X	TYPE IX FLUORESCENT YELLOW SHEETING			
SB	3.767	F	W1-8				LEFT CHEVRON															4-26-18							
		E	W1-8				RIGHT CHEVRON																						
SB	3.767	F	W1-8	24	30	FY		5.00														13.25 X			X	TYPE IX FLUORESCENT YELLOW SHEETING			
SB	3.766	E	W1-8	24	30	FY		5.00														13.25 X			X	TYPE IX FLUORESCENT YELLOW SHEETING			
SB	3.757	F	W1-8	24	30	FY		5.00														13.75 X			X	INSTALL 55 FT ± SOUTH OF EXISTING SIGN AT MP 3.767. TYPE IX FLUORESCENT YELLOW SHEETING			
SB	3.756	E	W1-8	24	30	FY		5.00														14.00 X			X	TYPE IX FLUORESCENT YELLOW SHEETING			
SB	3.593	G	W1-7	48	24			8.00														12.50 X 12.50			X	INSTALL 15 FT ± NORTH OF EXISTING SIGN AT MP 3.590			
SB	3.590	G	W1-7				TWO DIRECTION LARGE ARROW																						
SB	2.795	F	W2-2L	30	30			6.25														14.75 X			X	INSTALL 30 ± NORTH OF UTILITY POLE VTELEC/72A/20A AT MP 2.789			
		F	W16-8p	24	8			1.33																		19			
SIGN SUMMARY SHEET							SHEET TOTALS	45.58	0.00	0	0	0	5	0	0	9	123.00 135.0	0	0.0	0.0	0.0	0.0	PROJECT NAME: STATEWIDE-NORTH REGION						
							SF	SF	EA	EA	EA	EA	EA	EA	EA	EA	FT	EA	LB	LB	LB	LB	PROJECT NUMBER: STP HRRR(22)						
VERMONT AGENCY OF TRANSPORTATION							TOWN DIRECTIONAL TOTALS	372.2	0.0	0	0	0	50	0	0	80	1200.0	0			0.0		FILE NAME: z14k100tssouthhero TH13 S	PLOT DATE: 5/5/2017					
																						PROJECT MANAGER: K. RUTTER	DRAWN BY: R. SHEDD						
																						DESIGNED BY: R. SHEDD	CHECKED: S. GOODWIN						
																						SOUTH HERO TH-13 SOUTHBOUND 4	SHEET 206	OF	255				