






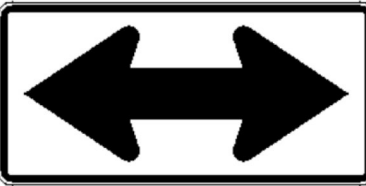


DIRECTION	MILEPOINT	LOCATION CODE (SHEET 4)	SIGN CODE	WIDTH (IN)	HEIGHT (IN)	SHEETING REMARKS	SIGN LEGEND	NEW SIGNS		EXISTING SIGNS			EXIST POST		NUMBER OF NEW POSTS	SQUARE STEEL (IN)			TUBULAR STEEL Ø (IN)				SIGN FRAME REQUIRED	REMARKS	SIGN DETAIL LOCATION				
								"A"	"B"	RETAIN	SALVAGE FROM	SALVAGE TO	REMOVE	RETAIN		REMOVE	1.75	2.00	2.50	FOUNDATION	3.00	3.50			4.00	5.00	SHSM	SIGN DETAIL SHEET #	STANDARD SHEET #
																	(LB / FT)				(LB / FT)								
SB SOUTH HERO TH-13							FY-FLUORESCENT YELLOW FYG-FLUORESCENT YELLOW GREEN															"SHSM"-STANDARD HIGHWAY SIGNS AND MARKINGS BOOK							
SB	2.750	G	W1-7				 TWO DIRECTION LARGE ARROW																						
		G	W1-7	48	24			8.00																INSTALL ACROSS FROM STATION RD ON WEST SHORE RD	X				
SB	2.728	F	R2-1				 SPEED LIMIT 35																						
		F	R2-1	24	30			5.00																		X			
SB	2.105	EF	D3-1				TOURVILLE DR																						
		EF	D3-1	42	12			3.50																					19
SB	1.900	EF	D3-1				JACKSON POINT RD																						
		EF	D3-1	72	12			6.00																					19
SB	1.874	F	W11-5				 FARM MACHINERY TRAFFIC WARNING																						
		F	W11-5	30	30			6.25																		X			
SB	1.631	F	W3-5	36	36		 SPEED LIMIT 25	9.00																					
																										X		INSTALL 100 FT ± SOUTH OF UTILITY POLE 51/VTELEC/72*45 AT MP 1.650	
SB	1.577	F	R2-1	30	36		 SPEED LIMIT 25	7.50																					
																									X		INSTALL 15 FT ± NORTH OF EXISTING SIGN AT MP 1.574		
SB	1.574	F	R2-1				SPEED LIMIT 25																						
SB	1.558	F	W1-2L				LEFT CURVE																						
SIGN SUMMARY SHEET							SHEET TOTALS	39.25 45.25	0.00	0	0	0	6 7	0	0	10	94.00 150.0	0	0.0	0.0	0.0	0.0		PROJECT NAME: STATEWIDE-NORTH REGION					
VERMONT AGENCY OF TRANSPORTATION							TOWN DIRECTIONAL TOTALS	372.2	0.0	0	0	0	50	0	0	80	1200.0	0		0.0			PROJECT NUMBER: STP HRRR(22)						
																						FILE NAME: z14k100tsssouthhero TH13 S							
																						PLOT DATE: 5/5/2017							
																						DRAWN BY: R. SHEDD							
																						CHECKED: S. GOODWIN							
																						SOUTH HERO TH-13 SOUTHBOUND 5							
																						SHEET 207 OF 255							