

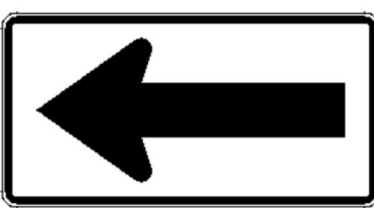
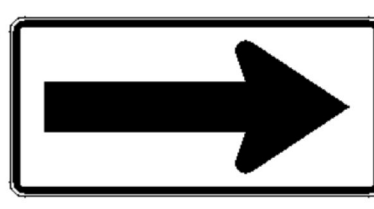
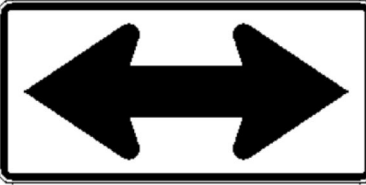
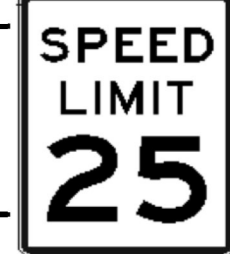


DIRECTION	MILEPOINT	LOCATION CODE (SHEET 4)	SIGN CODE	WIDTH (IN)	HEIGHT (IN)	SHEETING REMARKS	SIGN LEGEND	NEW SIGNS		EXISTING SIGNS			EXIST POST		NUMBER OF NEW POSTS	SQUARE STEEL (IN)			TUBULAR STEEL Ø (IN)				SIGN FRAME REQUIRED	REMARKS	SIGN DETAIL LOCATION				
								"A"	"B"	RETAIN	SALVAGE FROM	SALVAGE TO	REMOVE	RETAIN		REMOVE	1.75	2.00	2.50	FOUNDATION	3.00	3.50			4.00	5.00	SHSM	SIGN DETAIL SHEET #	STANDARD SHEET #
																	(LB / FT)				(LB / FT)								
SB SOUTH HERO TH-13							FY-FLUORESCENT YELLOW FYG-FLUORESCENT YELLOW GREEN															"SHSM"-STANDARD HIGHWAY SIGNS AND MARKINGS BOOK							
SB	1.479	F	W1-1L	30	30			6.25						1	15.75 X							4-24-18 INSTALL 90 FT ± NORTH OF EXISTING SIGNS AT MP 1.462	X						
		F	W13-1p	18	18			2.25															X						
SB	1.462	F	W1-8				LEFT CHEVRON																						
		E	W1-8				RIGHT CHEVRON																						
SB	1.450	F	W1-8				LEFT CHEVRON																						
		E	W1-8				RIGHT CHEVRON																						
		F	W1-6	48	24			8.00						2	15.25 X 15.25									X					
SB	1.445	F	W1-8				LEFT CHEVRON																						
		E	W1-8				RIGHT CHEVRON																						
		E	W1-6	48	24			8.00						2	13.75 X 13.75									X					
SB	1.272	G	W1-7				TWO DIRECTION LARGE ARROW																						
		G	W1-7	48	24			8.00						1	14.00 X 14.00								INSTALL IN SAME LOCATION AS EXISTING, ACROSS FROM LAKE VIEW RD	X					
SB	1.270	G	R1-1				STOP																						
SB	1.260	F	R2-1	24	30			5.00						1	13.25 X								INSTALL 25 FT ± NORTH OF UTILITY POLE 26 28/VTELEC/ 72/37A/69 AT MP 1.255 4-21-18	X					
SB	1.238	F					DETOUR 15 M.P.H. AHEAD																						
SIGN SUMMARY SHEET							SHEET TOTALS	37.50	0.00	0	0	0	9	0	0	7	115.00 105.0	0	0.0	0.0	0.0	0.0	PROJECT NAME: STATEWIDE-NORTH REGION						
								SF	SF	EA	EA	EA	EA	EA	EA	EA	FT	EA	LB	LB	LB	PROJECT NUMBER: STP HRRR(22)							
VERMONT AGENCY OF TRANSPORTATION							TOWN DIRECTIONAL TOTALS	372.2	0.0	0	0	0	50	0	0	80	1200.0	0		0.0		FILE NAME: z14k100tsssouthhero TH13 S	PLOT DATE: 5/5/2017						
																				PROJECT MANAGER: K. RUTTER	DRAWN BY: R. SHEDD								
																				DESIGNED BY: R. SHEDD	CHECKED: S. GOODWIN								
																				SOUTH HERO TH-13 SOUTHBOUND 6	SHEET 208	OF 255							