






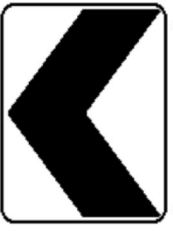



DIRECTION	MILEPOINT	LOCATION CODE (SHEET 4)	SIGN CODE	WIDTH (IN)	HEIGHT (IN)	SHEETING REMARKS	SIGN LEGEND	NEW SIGNS		EXISTING SIGNS			EXIST POST		NUMBER OF NEW POSTS	SQUARE STEEL (IN)			TUBULAR STEEL Ø (IN)				SIGN FRAME REQUIRED	REMARKS	SIGN DETAIL LOCATION				
								"A"	"B"	RETAIN	SALVAGE FROM	SALVAGE TO	REMOVE	RETAIN		REMOVE	1.75	2.00	2.50	FOUNDATION	3.00	3.50			4.00	5.00	SHSM	SIGN DETAIL SHEET #	STANDARD SHEET #
																	(LB / FT)				(LB / FT)								
<b>SB ST JOHNSBURY TH-8</b>							FY-FLUORESCENT YELLOW FYG-FLUORESCENT YELLOW GREEN															"SHSM"-STANDARD HIGHWAY SIGNS AND MARKINGS BOOK							
SB	1.753	F	R2-1				SPEED LIMIT 40																5-24-18						
SB	1.635	F	W1-10R	36	36			9.00															INSTALL ACROSS FROM UTILITY POLE #38 AT MP 1.635	X					
		F	W16-8p	36	8			2.00																	21				
		F	W13-1p	18	18			2.25															INSTALL ON LEFT POST	X					
SB	1.612	EF	D3-1				HUTCHINSON DR																						
		EF	D3-1	60	12			5.00																	21				
SB	1.055	F	R2-1				SPEED LIMIT 40																						
SB	1.050	F	W1-4R	30	30			6.25															<del>MOVED DUE TO LEDGE &amp; VISIBILITY</del> <del>INSTALL 50 FT ± NORTH AND</del> <del>ACROSS FROM DRIVE AT MP 1.040</del>	X					
SB	0.957 - 0.983	F		6	8		INSTALL (3) NEW DELINEATOR POSTS																INSTALL (6) TYPE II 6"x8" WHITE DELINEATORS BACK TO BACK ON ON 3 NEW POSTS; INSTALL FIRST POST AT MP 0.957, 1,000 FT ± NORTH OF UTILITY POLE 19/93/19-1, THEN EVERY 70 FT ±, SEE SHEET 9						
SB	0.788	F	W1-4L	30	30			6.25															INSTALL 50 FT ± SOUTH OF UTILITY POLE 19/93/19-1 AT MP 0.798	X					
		F	W13-1p	18	18			2.25																	X				
SB	0.757	F	W1-8	24	30			5.00															INSTALL 40 FT ± NORTH OF EXISTING SIGN AT MP 0.749	X					
SB	0.756	E	W1-8	24	30			5.00																	X				
SB	0.749	F	W1-8				LEFT CHEVRON																						
<b>SIGN SUMMARY SHEET</b>							SHEET TOTALS	43.00	0.00	2	0	0	2	0	0	8	111.75	0	0.0	0.0	0.0	0.0	PROJECT NAME: STATEWIDE-NORTH REGION						
							SF	SF	EA	EA	EA	EA	EA	EA	EA	FT	EA	LB	LB	LB	LB	PROJECT NUMBER: STP HRRR(22)							
VERMONT AGENCY OF TRANSPORTATION							TOWN DIRECTIONAL TOTALS	165.2	0.0	4	0	0	11	0	0	31	465.0	0		0.0			FILE NAME: z14k100tssstionhsburv TH8 ; PLOT DATE: 5/5/2017						
																					PROJECT MANAGER: K. RUTTER								
																					DRAWN BY: R. SHEDD								
																					DESIGNED BY: R. SHEDD								
																					CHECKED: S. GOODWIN								
																					ST. JOHNSBURY TH-8 SOUTHBOUND 3								
																					SHEET 220 OF 255								

3 DEL.

5-25-18  
INSTALL 40 FT ± NORTH OF EXISTING SIGN AT MP 0.749

5-24-18  
POSTS