




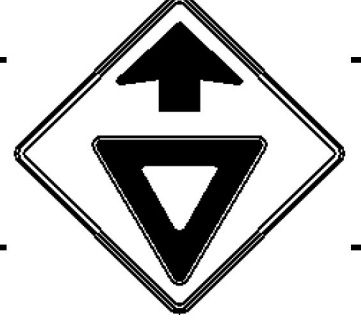





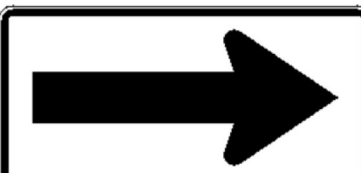


DIRECTION	MILEPOINT	LOCATION CODE (SHEET 4)	SIGN CODE	WIDTH (IN)	HEIGHT (IN)	SHEETING REMARKS	SIGN LEGEND	NEW SIGNS		EXISTING SIGNS			EXIST POST		NUMBER OF NEW POSTS	SQUARE STEEL (IN)			TUBULAR STEEL Ø (IN)				SIGN FRAME REQUIRED	REMARKS	SIGN DETAIL LOCATION				
								"A"	"B"	RETAIN	SALVAGE FROM	SALVAGE TO	REMOVE	RETAIN		REMOVE	1.75	2.00	2.50	FOUNDATION	3.00	3.50			4.00	5.00	SHSM	SIGN DETAIL SHEET #	STANDARD SHEET #
																	(LB / FT)				(LB / FT)								
NB ST JOHNSBURY TH-14							FY-FLUORESCENT YELLOW FYG-FLUORESCENT YELLOW GREEN															"SHSM"-STANDARD HIGHWAY SIGNS AND MARKINGS BOOK							
SB	0.485	H	R1-2	36	36			3.90		1												5-30-18 36"x36"x36"	NEW SIGN TO TOWN	X					
PIERCE ROAD																													
EB	0.480	A	W1-5L	30	30			6.25						1	14.75	X						INSTALL 10 FT ± EAST OF UTILITY POLE 65/35-2 AT MP 0.478		X					
		A	W13-1p	18	18			2.25																X					
EB	0.963	A	W1-6	48	24			8.00						2	12.25	X									X				
EB	0.969	B	W1-6	48	24			8.00						2	12.00	X										X			
EB	1.078	A	W3-2	30	30			6.25						1	13.25	X										X			
EB	1.095	A	W1-6	48	24			8.00						2	12.00	X										X			
EB	1.095	B	W1-6	48	24			8.00						2	12.00	X										X			
WB	1.130	F	W1-5R	30	30			6.25						1	14.75	X										X			
		F	W13-1p	18	18			2.25																	X				
WB	1.040	F	W1-6	48	24			8.00						2	13.00	X							5-31-18		X				
WB	1.040	E	W1-6	48	24			8.00						2	13.00	X										X			
SIGN SUMMARY SHEET							SHEET TOTALS	75.15	0.00	0	0	0	0	0	0	16	192.75		0	0.0	0.0	0.0	0.0	PROJECT NAME: STATEWIDE-NORTH REGION					
								SF	SF	EA	EA	EA	EA	EA	EA	EA	EA	EA	EA	EA	EA	EA	EA	PROJECT NUMBER: STP HRRR(22)					
VERMONT AGENCY OF TRANSPORTATION							TOWN DIRECTIONAL TOTALS	149.2	0.0	0	0	0	0	0	0	29	435.0		0		0.0			FILE NAME: z14k100stjohnsbury TH14 NB	PLOT DATE: 5/5/2017				
																						PROJECT MANAGER: K. RUTTER	DRAWN BY: R. SHEDD						
																						DESIGNED BY: R. SHEDD	CHECKED: S. GOODWIN						
																						ST. JOHNSBURY TH-14 NORTHBOUND 2	SHEET 223	OF	255				