


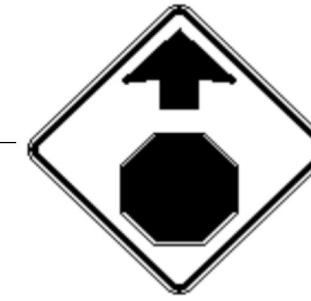



DIRECTION	MILEPOINT	LOCATION CODE (SHEET 4)	SIGN CODE	WIDTH (IN)	HEIGHT (IN)	SHEETING REMARKS	SIGN LEGEND	NEW SIGNS		EXISTING SIGNS			EXIST POST		NUMBER OF NEW POSTS	SQUARE STEEL (IN)			TUBULAR STEEL Ø (IN)				SIGN FRAME REQUIRED	REMARKS	SIGN DETAIL LOCATION				
								"A"	"B"	RETAIN	SALVAGE FROM	SALVAGE TO	REMOVE	RETAIN		REMOVE	1.75	2.00	2.50	FOUNDATION	3.00	3.50			4.00	5.00	SHSM	SIGN DETAIL SHEET #	STANDARD SHEET #
																	(LB / FT)				(LB / FT)								
WB WARREN TH-5							FY-FLUORESCENT YELLOW FYG-FLUORESCENT YELLOW GREEN															"SHSM"-STANDARD HIGHWAY SIGNS AND MARKINGS BOOK							
WB	2.874	E	R1-1	30	30			6.25						1	13.25 X								INSTALL ACROSS FROM EXISTING STOP SIGN 6-5-18	X					
WB	2.861	F	VR-017																										
		F	VR-017	24	30			5.00															SLIP BASE REQUIRED SEE SHEET 9			T-70			
		F	R2-1	24	30			5.00																X					
WB	2.830	F	R2-1				SPEED LIMIT 40																						
WB	2.745	EF	D3-1				CHRISTMAS TREE RD			1																			
WB	2.699	E	W3-1																										
		E	W3-1	30	30			6.25															INSTALL FACING EB TRAFFIC	X					
WB	2.641	EF	D3-1				LOWER PINES RD			1																			
WB	2.632	G					CAUTION CHILDREN PLAYING																						
WB	2.455	EF	D3-1				UPPER PINES RD			1																			
WB	2.432	EF	D3-1				GOLD HILL RD			1																			
WB	2.347	F	R2-1				SPEED LIMIT 40			1																			
WB	2.108	EF	D3-1				TISHMAN RD																						
		EF	D3-1	42	12			3.50																		22			
SIGN SUMMARY SHEET							SHEET TOTALS	26.00	0.00	5	0	0	5	0	0	4	53.25 60.0	0	0.0	0.0	0.0	0.0	PROJECT NAME: STATEWIDE-NORTH REGION						
								SF	SF	EA	EA	EA	EA	EA	EA	EA	FT	EA	LB	LB	LB	PROJECT NUMBER: STP HRRR(22)							
VERMONT AGENCY OF TRANSPORTATION							TOWN DIRECTIONAL TOTALS	211.3	0.0	9	2	2	22	0	0	38	570.0	0		0.0		FILE NAME: z14k100tsswarrenTH5 WB.xls	PLOT DATE: 5/5/2017						
																					DESIGNED BY: R. SHEDD	DRAWN BY: R. SHEDD							
																					CHECKED: S. GOODWIN	SHEET 232	OF 255						