




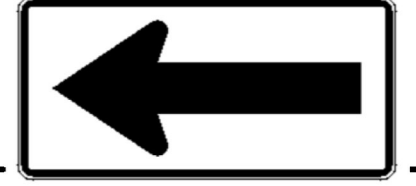



DIRECTION	MILEPOINT	LOCATION CODE (SHEET 4)	SIGN CODE	WIDTH (IN)	HEIGHT (IN)	SHEETING REMARKS	SIGN LEGEND	NEW SIGNS		EXISTING SIGNS			EXIST POST		NUMBER OF NEW POSTS	SQUARE STEEL (IN)			TUBULAR STEEL Ø (IN)				SIGN FRAME REQUIRED	REMARKS	SIGN DETAIL LOCATION				
								"A"	"B"	RETAIN	SALVAGE FROM	SALVAGE TO	REMOVE	RETAIN		REMOVE	1.75	2.00	2.50	FOUNDATION	3.00	3.50			4.00	5.00	SHSM	SIGN DETAIL SHEET #	STANDARD SHEET #
																	(LB / FT)				(LB / FT)								
WB WARREN TH-5							FY-FLUORESCENT YELLOW FYG-FLUORESCENT YELLOW GREEN															"SHSM"-STANDARD HIGHWAY SIGNS AND MARKINGS BOOK							
WB	0.748	F	W1-2MbL	36	36			9.00							2	14.50 X 14.00							5-31-18 INSTALL ACROSS FROM UTILITY POLE 59/481/6/10		27				
		F	W16-8p	36	8			2.00																22					
WB	0.667 - 0.733	F		6	8		INSTALL (5) NEW DELINEATOR POSTS																INSTALL (10) TYPE II 6"x8" WHITE DELINEATORS BACK TO BACK ON 5 NEW POSTS; INSTALL THE FIRST POST AT MP 0.667 75 FT ± EAST OF GOLF COURSE RD. THEN EVERY 70 FT ±, SEE SHEET 9						
WB	0.555	EF	D3-1				COLONY RD			1													5-30-18						
WB	0.516	F	W1-5R	30	30			6.25							1	15.00 X							INSTALL ACROSS FROM UTILITY POLE GMPCORP/64/542/6/5	X					
		F	W13-1p	18	18			2.25																X					
WB	0.458	F	VW-133R				HIDDEN DRIVE RIGHT																						
		F					BUS SIGN (LOCAL TRANSIT)			1																			
		F	VW-133R	30	30			6.25							1	14.25 X										T-81			
		F					BUS SIGN (LOCAL TRANSIT)			1																			
WB	0.410	F	R2-1				SPEED LIMIT 40																						
		F	W1-2L				LEFT CURVE																						
WB	0.383	F	W1-6	48	24			8.00							2	12.75 X 12.75							INSTALL 125 FT ± EAST OF UTILITY POLE GMP/68/558/6/1 AT MP 0.359	X					
WB	0.381	E	W1-6	48	24			8.00							2	12.75 X 12.75						5 DEL.	INSTALL FACING EB TRAFFIC. ASSURE NO MORE THAN 2 POSTS IN 8 FT PATH	X					
SIGN SUMMARY SHEET							SHEET TOTALS	41.75	0.00	1	1	1	4	0	0	8	108.75 X 120.0	0	0.0	0.0	0.0	0.0	PROJECT NAME: STATEWIDE-NORTH REGION						
								SF	SF	EA	EA	EA	EA	EA	EA	EA	FT	EA	LB	LB	LB	LB	PROJECT NUMBER: STP HRRR(22)						
VERMONT AGENCY OF TRANSPORTATION							TOWN DIRECTIONAL TOTALS	211.3	0.0	9	2	2	22	0	0	38	570.0	0		0.0			FILE NAME: z14k100tsswarrenTH5 WB.xls	PLOT DATE: 5/5/2017					
																						PROJECT MANAGER: K. RUTTER	DRAWN BY: R. SHEDD						
																						DESIGNED BY: R. SHEDD	CHECKED: S. GOODWIN						
																						WARREN TH-5 WESTBOUND 5	SHEET 236	OF 255					