

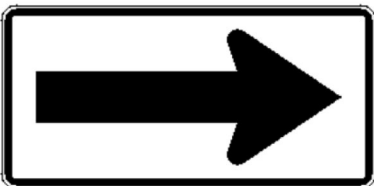



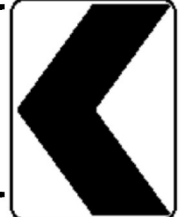
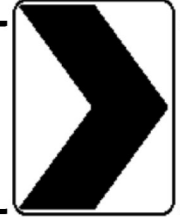
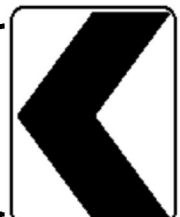
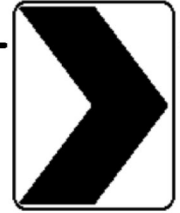


DIRECTION	MILEPOINT	LOCATION CODE (SHEET 4)	SIGN CODE	WIDTH (IN)	HEIGHT (IN)	SHEETING REMARKS	SIGN LEGEND	NEW SIGNS		EXISTING SIGNS			EXIST POST		NUMBER OF NEW POSTS	SQUARE STEEL (IN)			TUBULAR STEEL Ø (IN)				SIGN FRAME REQUIRED	REMARKS	SIGN DETAIL LOCATION				
								"A"	"B"	RETAIN	SALVAGE FROM	SALVAGE TO	REMOVE	RETAIN		REMOVE	1.75	2.00	2.50	FOUNDATION	3.00	3.50			4.00	5.00	SHSM	SIGN DETAIL SHEET #	STANDARD SHEET #
																	(LB / FT)				(LB / FT)								
<b>NB WOLCOTT TH-1</b>							FY-FLUORESCENT YELLOW FYG-FLUORESCENT YELLOW GREEN															"SHSM"-STANDARD HIGHWAY SIGNS AND MARKINGS BOOK							
NB	0.028	A	VR-017				LLL 24,000 LBS			1				X										5-10-18					
NB	0.047	A	R2-1				SPEED LIMIT 35			1				X															
NB	0.321	A	W1-1L				LEFT TURN						1		X														
		A	W1-1L	30	30			6.25								1	16.75	X								X			
		A	W13-1p	18	18			2.25																			X		
NB	0.371	B	W1-6				LARGE ARROW						1		X														
		B	W1-6	48	24			8.00								2	11.75	X									X		
NB	0.379	A	W1-6				LARGE ARROW						1		X														
		A	W1-6	48	24			8.00								2	12.25	X									X		
NB	0.454	A	W1-5L	30	30			6.25								1	15.25	X						INSTALL 395 FT ± NORTH OF EXISTING SIGN AT MP 0.379	X				
		A	W13-1p	18	18			2.25																6-19-18			X		
NB	0.490	A	W1-8	24	30			5.00								1	13.75	X						INSTALL 190 FT ± NORTH OF PROPOSED SIGN AT MP 0.454	X				
NB	0.491	B	W1-8	24	30			5.00								1	13.25	X									X		
NB	0.505	A	W1-8	24	30			5.00								1	13.25	X							INSTALL 80 FT ± NORTH OF PROPOSED SIGN AT MP 0.490	X			
NB	0.506	B	W1-8	24	30			5.00								1	13.75	X									X		
<b>SIGN SUMMARY SHEET</b>							SHEET TOTALS	53.00	0.00	2	0	0	3	0	0	10	134.00		0	0.0	0.0	0.0	0.0	PROJECT NAME: STATEWIDE-NORTH REGION					
VERMONT AGENCY OF TRANSPORTATION							TOWN DIRECTIONAL TOTALS	SF	SF	EA	EA	EA	EA	EA	EA	EA	EA	EA	EA	EA	EA	EA	EA	PROJECT NUMBER: STP HRRR(22)					
																							FILE NAME: z14k100tsswolcott TH1 NB.xl; PLOT DATE: 5/5/2017						
																							PROJECT MANAGER: K. RUTTER; DRAWN BY: R. SHEDD						
																							DESIGNED BY: R. SHEDD; CHECKED: S. GOODWIN						
																								WOLCOTT TH-1 NORTHBOUND 1; SHEET 244 OF 255					