
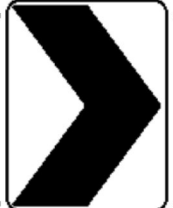

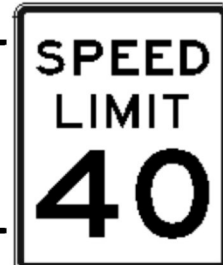



DIRECTION	MILEPOINT	LOCATION CODE (SHEET 4)	SIGN CODE	WIDTH (IN)	HEIGHT (IN)	SHEETING REMARKS	SIGN LEGEND	NEW SIGNS		EXISTING SIGNS			EXIST POST		NUMBER OF NEW POSTS	SQUARE STEEL (IN)			TUBULAR STEEL Ø (IN)				SIGN FRAME REQUIRED	REMARKS	SIGN DETAIL LOCATION				
								"A"	"B"	RETAIN	SALVAGE FROM	SALVAGE TO	REMOVE	RETAIN		REMOVE	1.75	2.00	2.50	FOUNDATION	3.00	3.50			4.00	5.00	SHSM	SIGN DETAIL SHEET #	STANDARD SHEET #
																	(LB / FT)				(LB / FT)								
NB WOLCOTT TH-1							FY-FLUORESCENT YELLOW FYG-FLUORESCENT YELLOW GREEN															"SHSM"-STANDARD HIGHWAY SIGNS AND MARKINGS BOOK							
NB	0.520	A	W1-8	24	30			5.00							1	13.75 X							5-10-18 INSTALL 80 FT ± NORTH OF PROPOSED SIGN AT MP 0.505	X					
NB	0.521	B	W1-8	24	30			5.00							1	13.75 X									X				
NB	0.835	A	R2-1										1		X														
		A	R2-1	24	30			5.00						1	13.50 X									X					
NB	1.136	C	R12-1							1				X															
		C	R2-1							1																			
NB	1.141	D	D3-1							1				X															
		D	R1-1							1																			
NB	1.159	A	R2-1	24	30			5.00							1	14.50 X							5-14-18 INSTALL 295 FT ± SOUTH OF EXISTING SIGNS AT MP 1.215	X					
NB	1.215	A	R2-1									1		X															
		A										1																	
NB	1.568	A										1		X									REMOVE OLD RUSTY SIGN						
NB	1.600	A	R2-1									1		X															
		A	R2-1	24	30			5.00							1	14.75 X								X					
NB	2.215	A										1		X															
SIGN SUMMARY SHEET							SHEET TOTALS	25.00	0.00	4	0	0	6	0	0	5	70.25 75.0	0	0.0	0.0	0.0	0.0	PROJECT NAME: STATEWIDE-NORTH REGION						
							SF	SF	EA	EA	EA	EA	EA	EA	EA	EA	EA	EA	EA	EA	EA	EA	PROJECT NUMBER: STP HRRR(22)						
VERMONT AGENCY OF TRANSPORTATION							TOWN DIRECTIONAL TOTALS	148.9	0.0	6	0	0	19	0	0	29	435.0	0		0.0			FILE NAME: z14k100tsswolcott TH1 NB.xl; PLOT DATE: 5/5/2017						
																						PROJECT MANAGER: K. RUTTER; DRAWN BY: R. SHEDD							
																						DESIGNED BY: R. SHEDD; CHECKED: S. GOODWIN							
																						WOLCOTT TH-1 NORTHBOUND 2; SHEET 245 OF 255							