

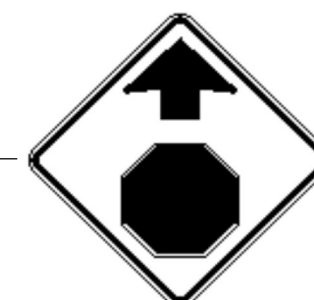


DIRECTION	MILEPOINT	LOCATION CODE (SHEET 4)	SIGN CODE	WIDTH (IN)	HEIGHT (IN)	SHEETING REMARKS	SIGN LEGEND	NEW SIGNS		EXISTING SIGNS			EXIST POST		NUMBER OF NEW POSTS	SQUARE STEEL (IN)			TUBULAR STEEL Ø (IN)				SIGN FRAME REQUIRED	REMARKS	SIGN DETAIL LOCATION				
								"A"	"B"	RETAIN	SALVAGE FROM	SALVAGE TO	REMOVE	RETAIN		REMOVE	1.75	2.00	2.50	FOUNDATION	3.00	3.50			4.00	5.00	SHSM	SIGN DETAIL SHEET #	STANDARD SHEET #
																	(LB / FT)				(LB / FT)								
SB WOLCOTT TH-1							FY-FLUORESCENT YELLOW FYG-FLUORESCENT YELLOW GREEN															"SHSM"-STANDARD HIGHWAY SIGNS AND MARKINGS BOOK							
SB	0.660 - 0.560	F		6	8		INSTALL (11) NEW DELINEATOR POSTS															INSTALL (22) TYPE II 6"x8" WHITE DELINEATORS BACK TO BACK ON 11 NEW POSTS; INSTALL THE FIRST POST AT MP 0.660, 735 FT ± SOUTH OF WEST HILL RD, THEN EVERY 55 FT ±, SEE SHEET 9							
SB	0.422	F	W1-1R	30	30			6.25						1				16.00					INSTALL 20 FT ± NORTH OF UTILITY POLE 14 AT MP 0.422	X					
		F	W13-1p	18	18			2.25																X					
SB	0.100	F	W3-1				 STOP AHEAD					1																	
		F	W3-1	30	30			6.25						1				13.50						X					
SB	0.028	F	R1-1				STOP			1																			
SIGN SUMMARY SHEET							SHEET TOTALS	14.75	0.00	1	0	0	1	0	0	2				29.50	0	0.0	0.0	0.0	0.0	PROJECT NAME: STATEWIDE-NORTH REGION			
VERMONT AGENCY OF TRANSPORTATION							TOWN DIRECTIONAL TOTALS	SF	SF	EA	EA	EA	EA	EA	EA	EA	FT				EA	LB	LB	LB	LB	PROJECT NUMBER: STP HRRR(22)			
								177.2	0.0	1	0	0	27	0	0	34	510.0				0		0.0			FILE NAME: z14k100tsswolcott TH1 SB.xl; PLOT DATE: 5/5/2017			
																									PROJECT MANAGER: K. RUTTER; DRAWN BY: R. SHEDD				
																									DESIGNED BY: R. SHEDD; CHECKED: S. GOODWIN				
																									WOLCOTT TH-1 SOUTHBOUND 5; SHEET 252 OF 255				

11 DEL

5-16-18

5-11-18

5-14-18