

STATE OF VERMONT AGENCY OF TRANSPORTATION





PROPOSED IMPROVEMENT TOWN OF RUTLAND COUNTY OF RUTLAND US ROUTE 7 (PRINCIPAL ARTERIAL) (NHS)

LOCATED IN THE TOWN OF RUTLAND AT THE INTERSECTION OF US ROUTE 7 AND SEWARD ROAD
(T.H. #36) AT MILE MARKER 0.84.

PROJECT LENGTH ON US 7 = 275.00 FEET = 0.052 MILES

REPLACEMENT AND UPGRADE OF TRAFFIC SIGNAL EQUIPMENT TO INCLUDE NEW MAST ARMS
AND MAST ARM POLES, NEW VEHICLE DETECTION, NEW PEDESTRIAN EQUIPMENT, A NEW SIGNAL
CONTROLLER AND OTHER HIGHWAY RELATED ITEMS.

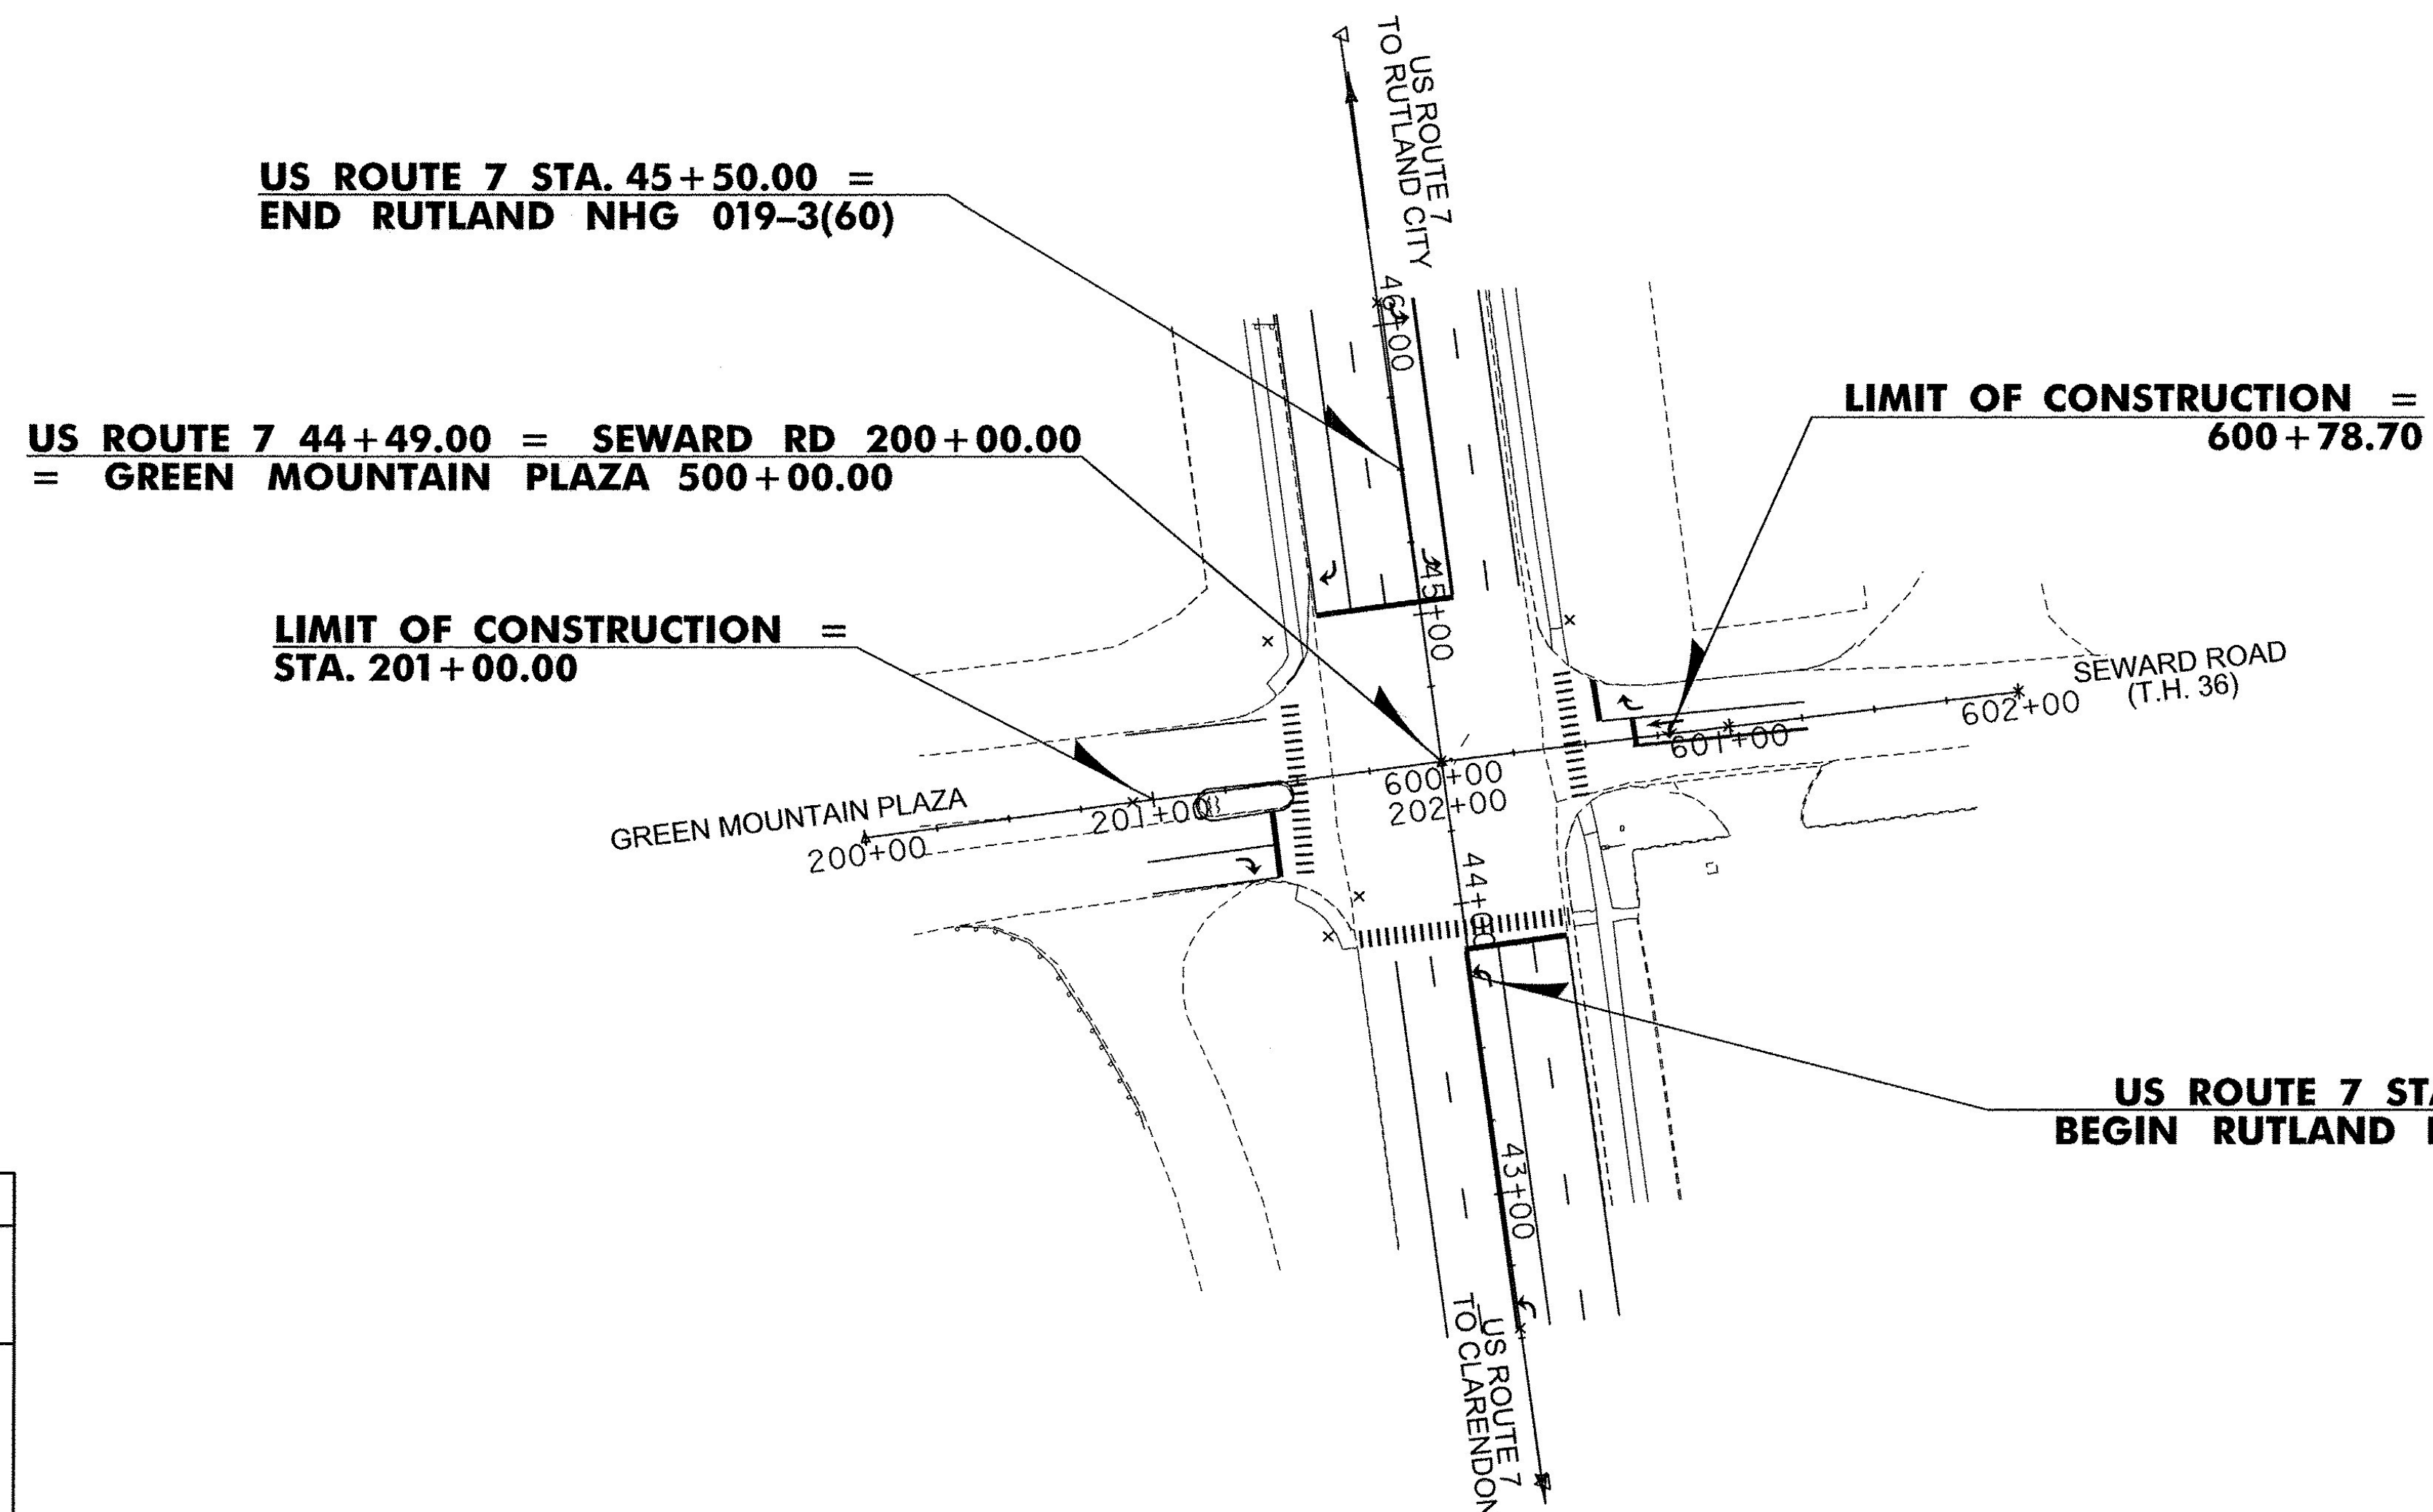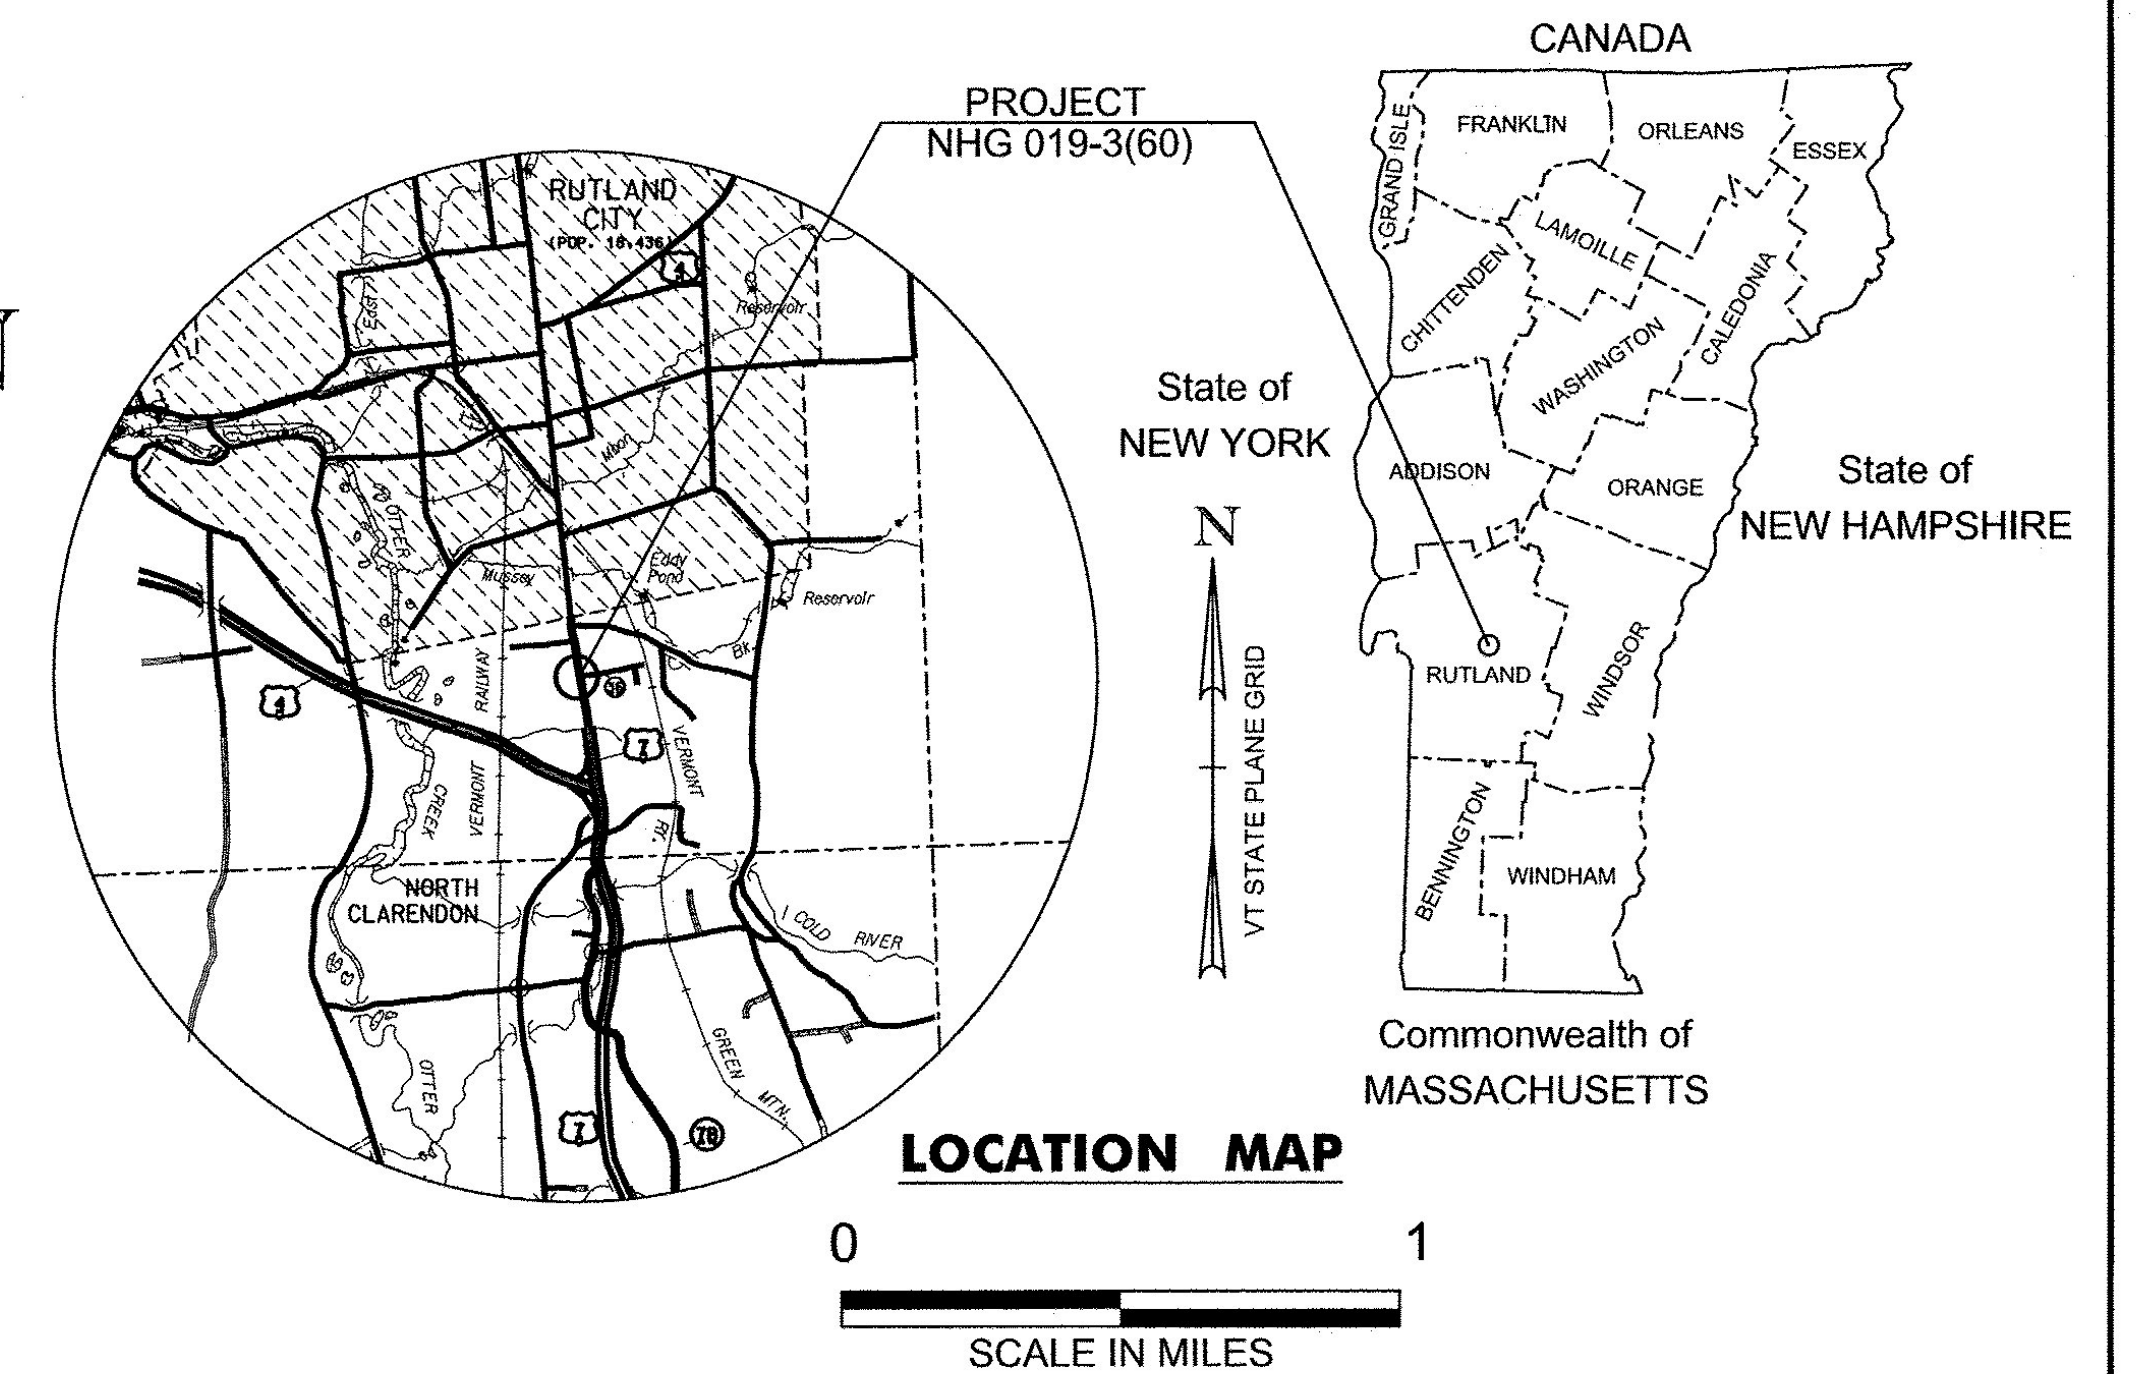

Record Plans
Contractor: THE BELDEN COMPANY
Resident Engineer: JACE CURTIS
Construction Began: SEPTEMBER 11, 2017
Construction Complete: JULY 9, 2018
Record Plans By: JACE CURTIS

I hereby certify that all construction required by this set of drawings has been accomplished as indicated herein.

e-Signed by Jace Curtis
BY: on 2018-09-14 19:49:21 GMT Resident Engineer

Date: September 14, 2018

NOTE: Any further information concerning final quantities, amounts or other details relative to this project may be found at Central Files in the electronic archives.

CONSTRUCTION IS TO BE CARRIED ON IN ACCORDANCE WITH THESE PLANS AND THE STANDARD SPECIFICATIONS FOR CONSTRUCTION DATED 2011, AS APPROVED BY THE FEDERAL HIGHWAY ADMINISTRATION ON JULY 20, 2011 FOR USE ON THIS PROJECT, INCLUDING ALL SUBSEQUENT REVISIONS AND SUCH REVISED SPECIFICATIONS AND SPECIAL PROVISIONS AS ARE INCORPORATED IN THESE PLANS.

QUALITY ASSURANCE PROGRAM : LEVEL 1

SURVEYED BY : VTRANS
SURVEYED DATE : FEBRUARY 24, 2016

DATUM
VERTICAL : NAVD 88
HORIZONTAL : NAD 83 (2011)

DIRECTOR OF PROJECT DELIVERY
APPROVED *Jace Curtis* DATE 1/11/2017
PROJECT MANAGER : PATRICIA COBURN, P.E.
PROJECT NAME : RUTLAND TOWN
PROJECT NUMBER : NHG 019-3(60)
SHEET 1 OF 17 SHEETS

