
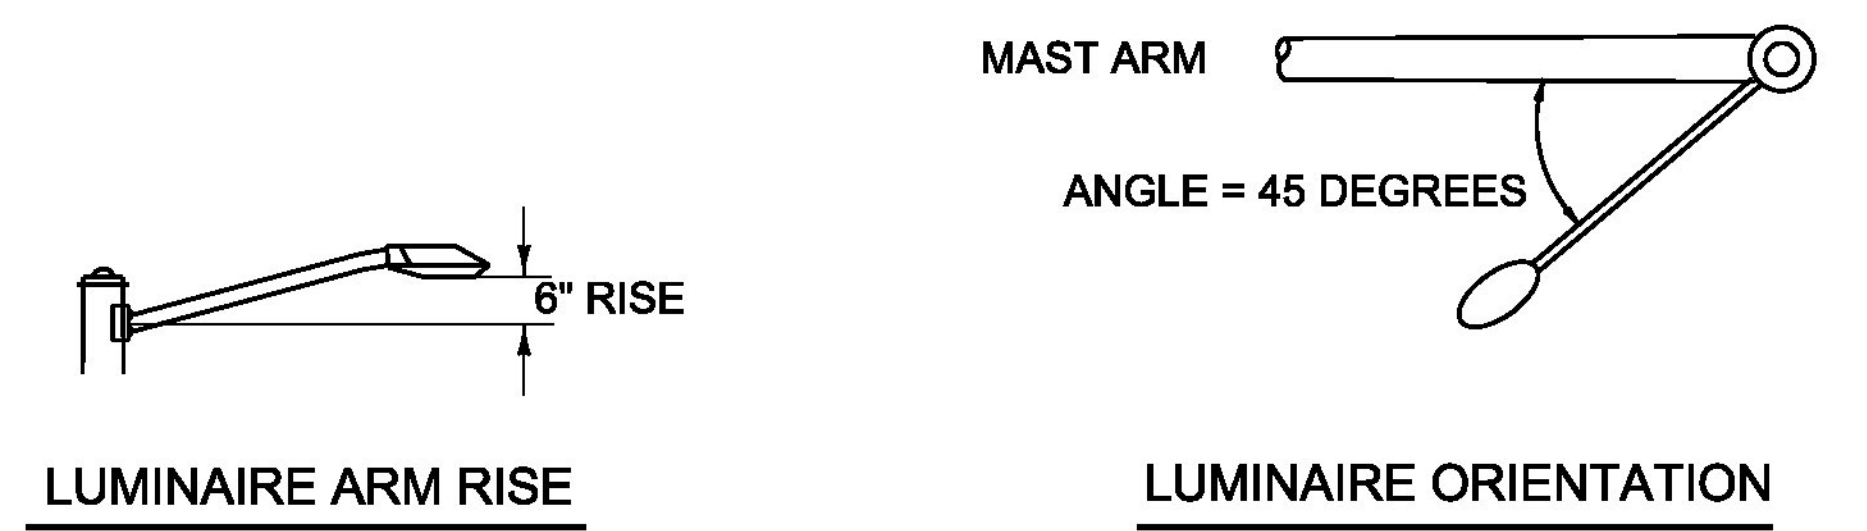
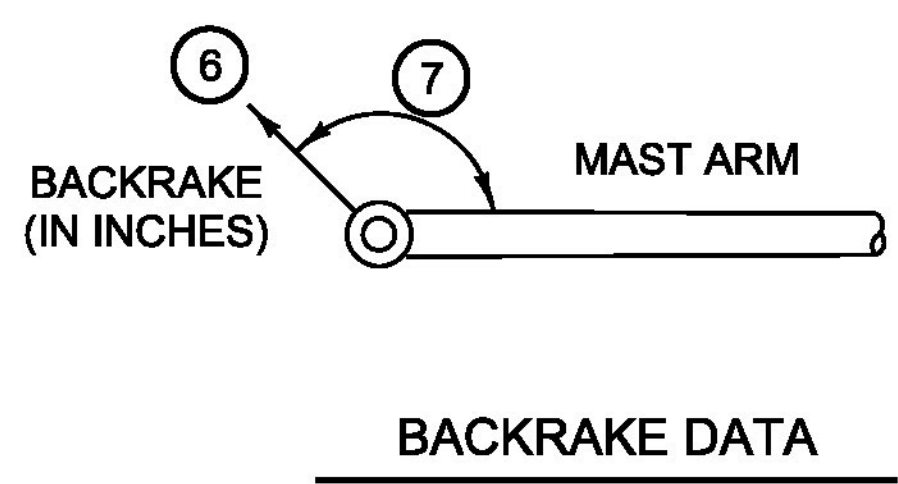
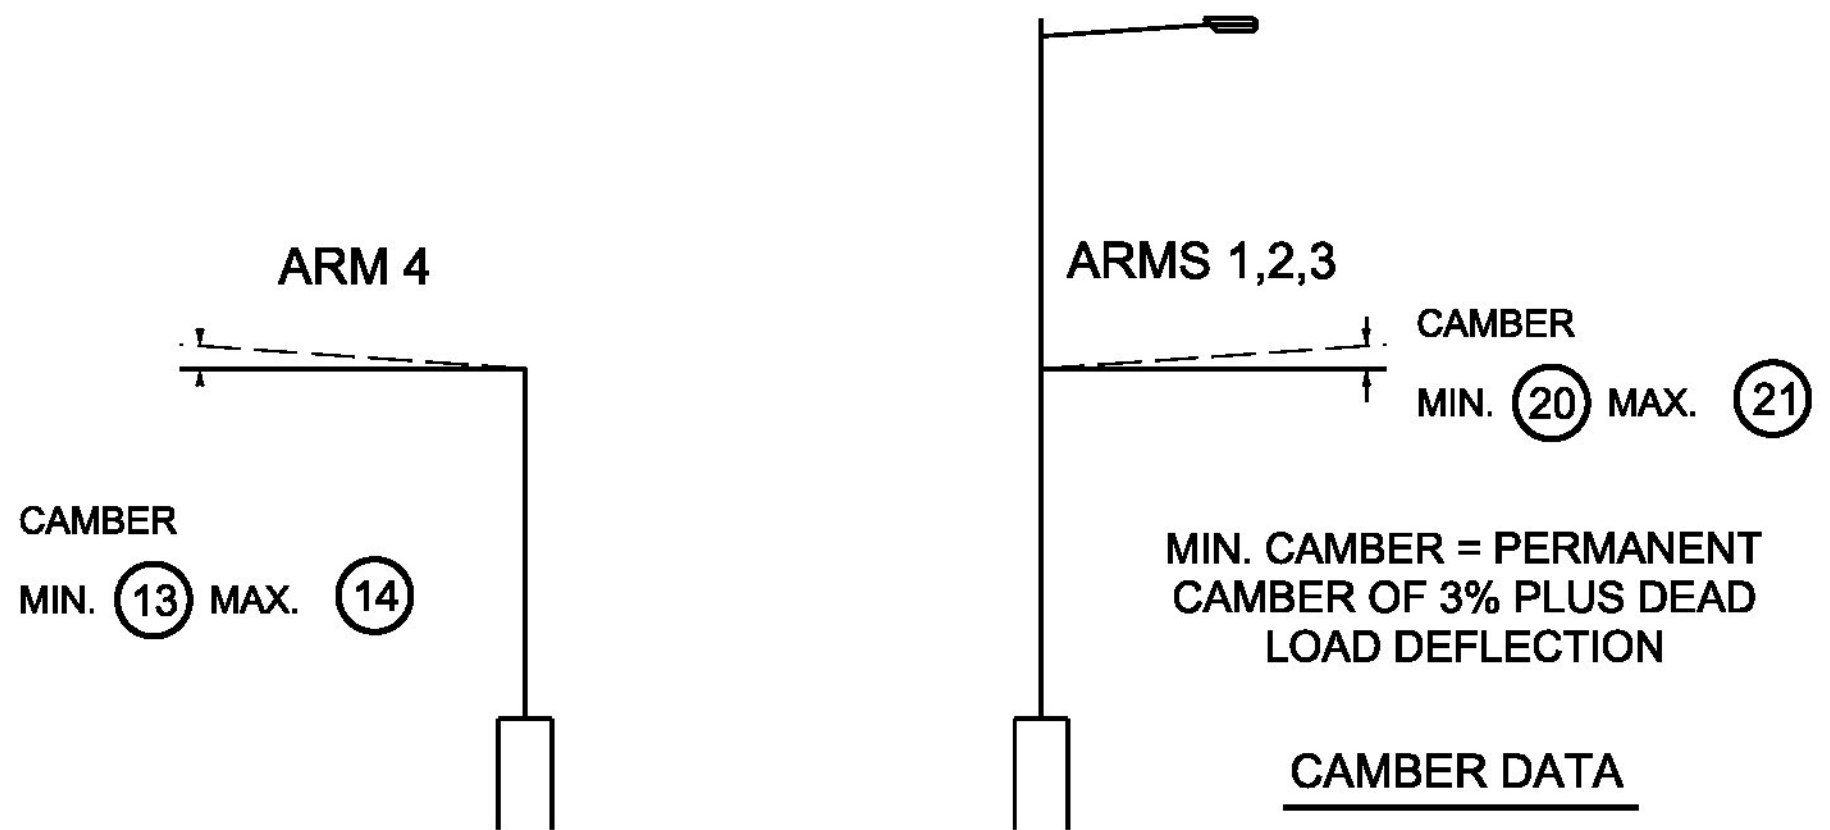


- MAP DETAILS**
- POLE BASE DIAMETER (3)
  - POLE GAUGE (4)
  - POLE TAPER RATE (5)

- ARM 1,2,3 DIAMETER (10)
- ARM 1,2,3 GAUGE (11)
- ARM 1,2,3 TAPER RATE (12)
- ARM 4 DIAMETER (17)
- ARM 4 GAUGE (18)
- ARM 4 TAPER RATE (19)

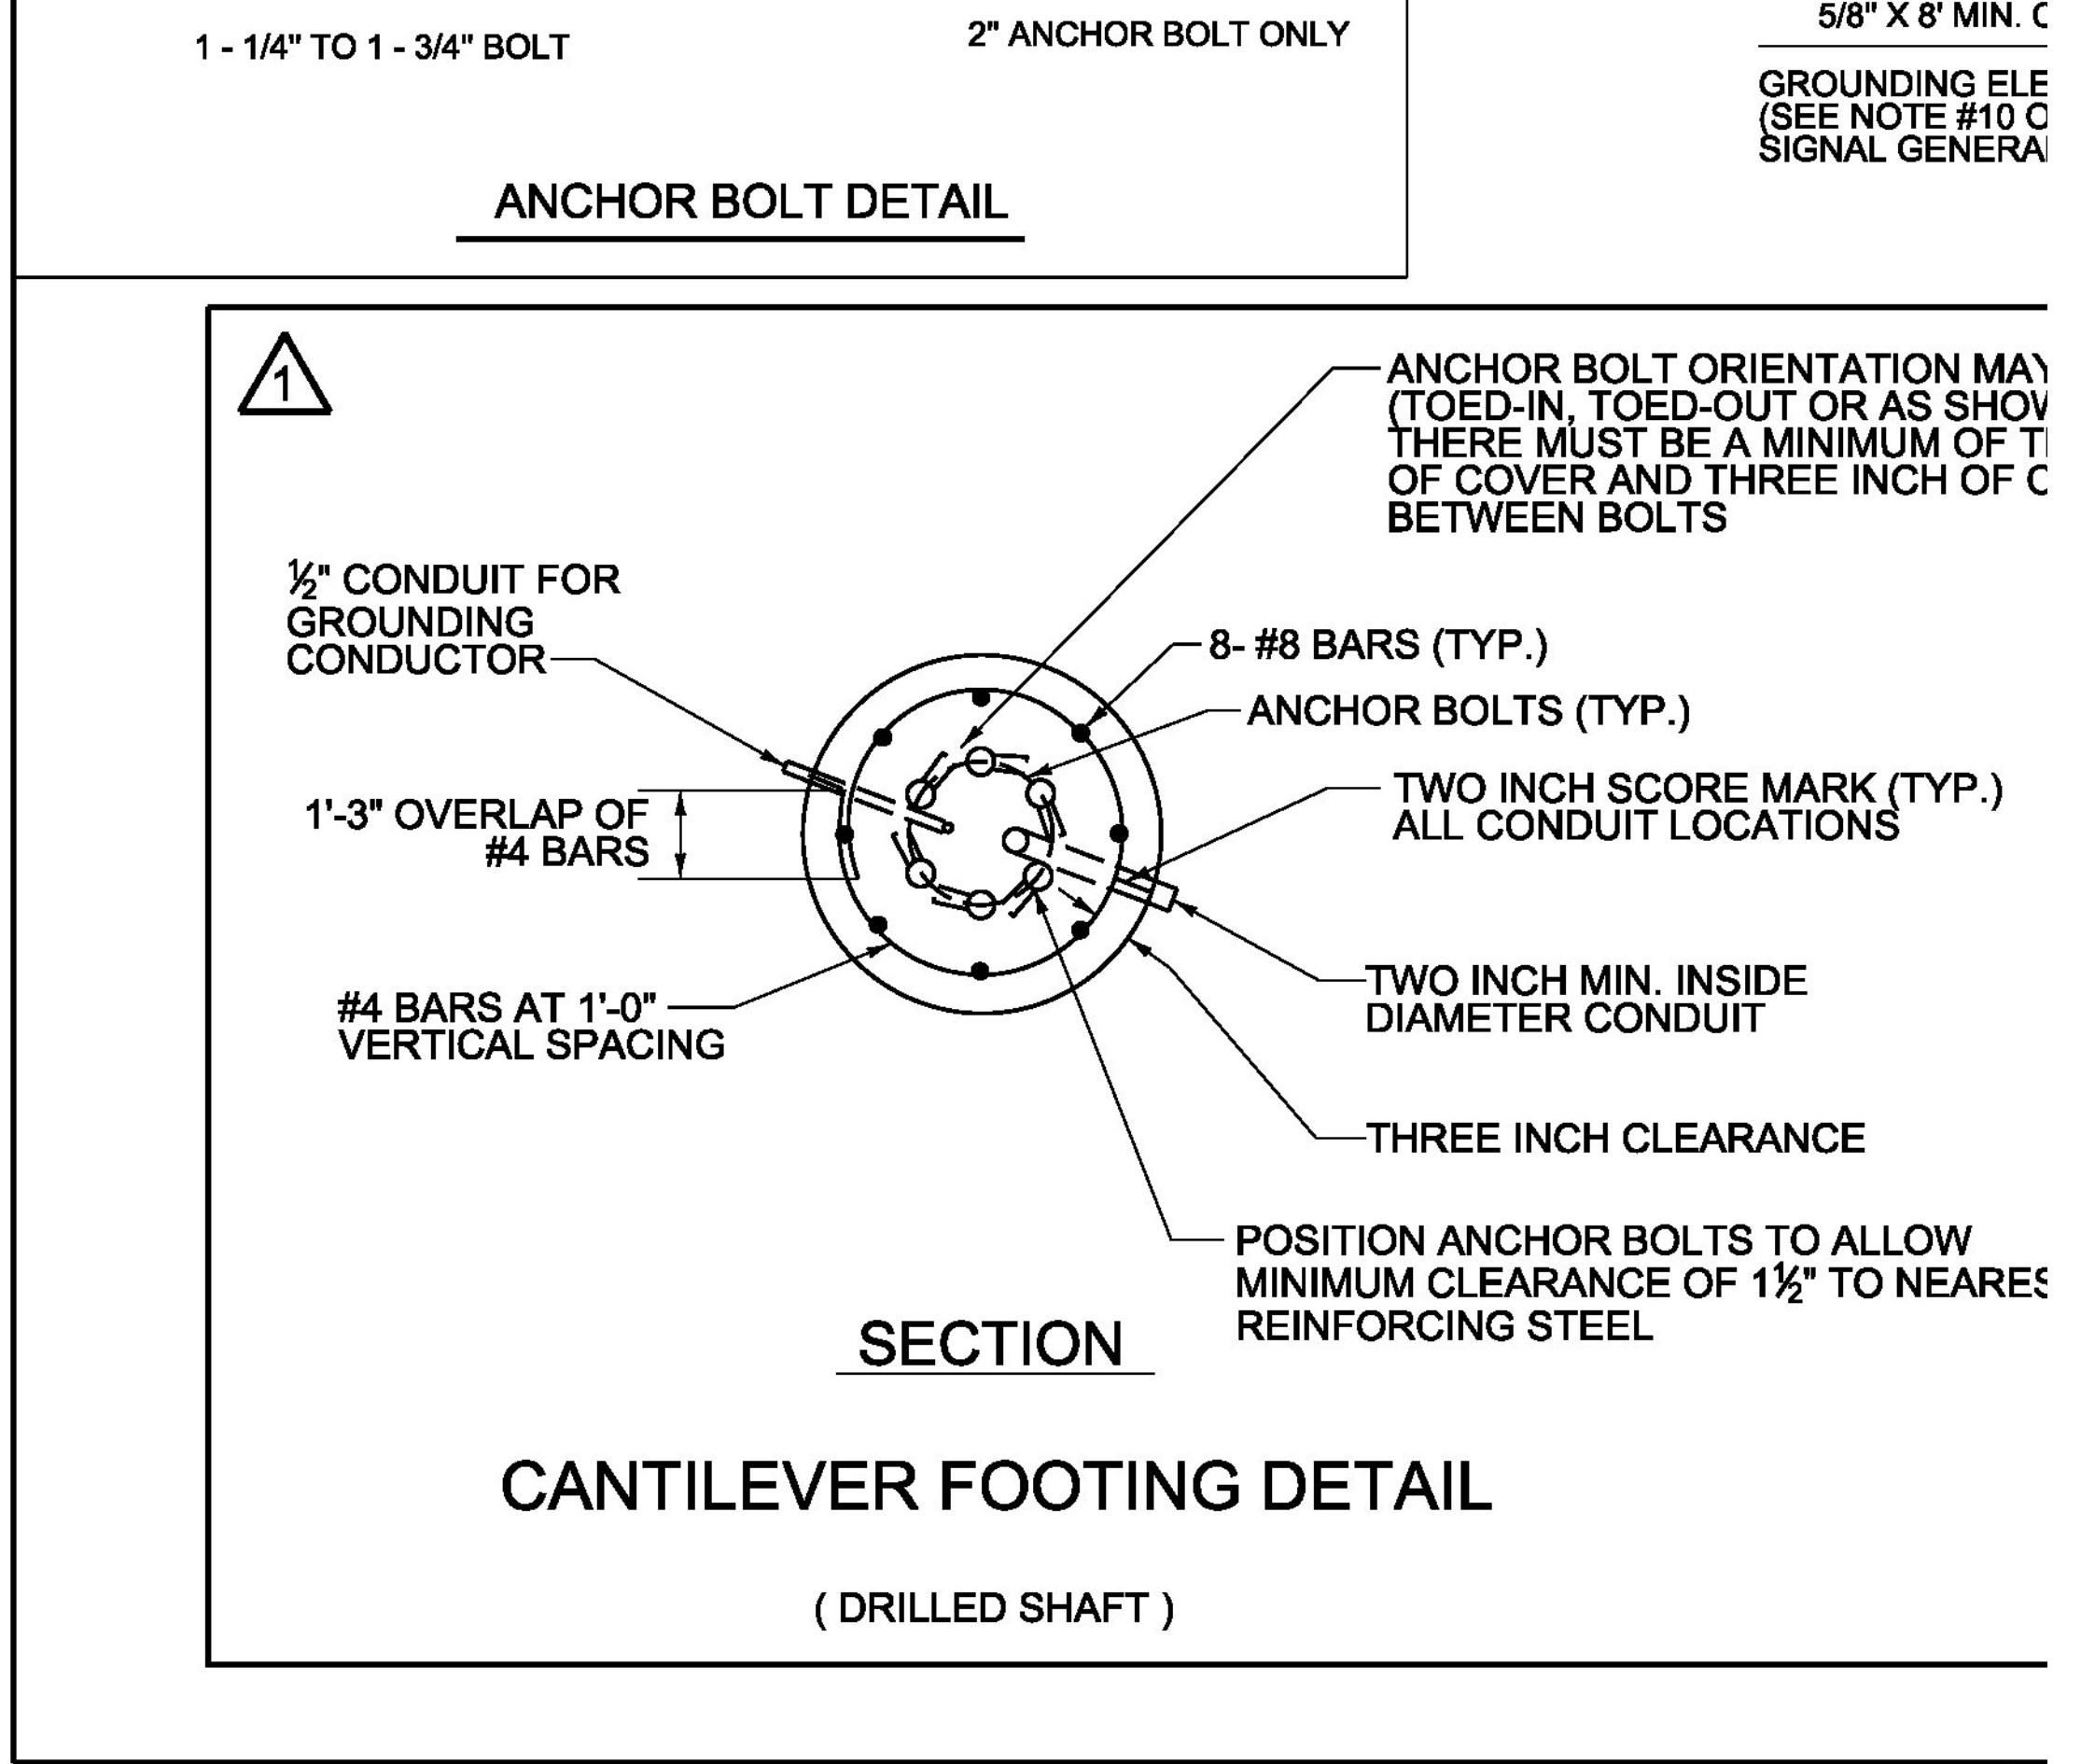

POLE	POLE DATA							ARM DATA														FOOTING DATA		BASE PLATE / BOLT DATA						
	(1)	(2)	(3)	(4)	(5)	(6)	(7)	(8)	(9)	(10)	(11)	(12)	(13)	(14)	(15)	(16)	(17)	(18)	(19)	(20)	(21)	(22)	(23)	(24)	(BC)	(F)	(S)	(T)	(P)	ANCHOR BOLT SIZE
MAP-1	30	20						35	18													16								
MAP-2	30	20						45	18													16								
MAP-3	30	20						55	18													16								
MAP-4	20.5	20						10	18																					

**NOTE:** DETAILS MAST ARM, CANTILEVER, & FOOTING DETAIL SHEET NTS

REV	DATE	DESCRIPTION
1	3/13/2017	1. CANTILEVER FOOTING DETAIL: UPDATED TO DEPICT MIN. 6 ANCHOR BOLTS. 2. POLE BASE AND BASE PLATE DETAIL: UPDATED TO DEPICT MIN. 6 ANCHOR BOLTS.