

Record Plans
 Contractor: PECKHAM ROAD CORPORATION
 Resident Engineer: Ronald Lemaire
 Construction Began: May 2, 2016
 Construction Complete: November 1, 2017
 Record Plans By: Paul Ruehn Jan 2017 / into BlueBeam by: Judy Gilmore April 2018

I hereby certify that all construction required by this set of drawings has been accomplished as indicated herein.

BY: e-Signed by Timothy Pockette on 2018-04-04 15:26:09 GMT Resident Engineer

Date: April 04, 2018

NOTE: Any further information concerning final quantities, amounts or other details relative to this project may be found at Central Files in the electronic archives.

STATE OF VERMONT AGENCY OF TRANSPORTATION





PROPOSED IMPROVEMENT TOWNS OF MANCHESTER, DORSET, WALLINGFORD, CLARENDON & RUTLAND TOWN COUNTIES OF BENNINGTON & RUTLAND U.S. ROUTE 7 - PRINCIPAL ARTERIAL (NHS)

BEGINNING IN THE TOWN OF MANCHESTER ON US ROUTE 7 AT MM 4.630 AND EXTENDING NORTHERLY
 ALONG US ROUTE 7 FOR A DISTANCE OF 24,472.80 FEET (4.635 MILES) AND STOPPING AT MM 1.745 IN THE TOWN OF DORSET.
 RESUMING IN THE TOWN OF WALLINGFORD AT MM 0.000 AND
 EXTENDING NORTHERLY 73,534.56 FEET (13.927 MILES) AND ENDING AT MM 1.177 IN RUTLAND TOWN

LENGTH OF ROADWAY = 98,007.36 FEET (18.562 MILES)
 LENGTH OF PROJECT = 98,007.36 FEET (18.562 MILES)

WORK TO BE PERFORMED UNDER THIS PROJECT INCLUDES SURFACE PREPARATION INVOLVING PATCHING, MICRO-MILLING, POT HOLE REPAIR, CRACK SEALING, OVERLAYING WITH A THIN BITUMINOUS SURFACE TREATMENT, TRAFFIC SIGNAL UPGRADES, TRAFFIC MARKINGS, RAIL CROSSING UPGRADES AND OTHER HIGHWAY RELATED ITEMS.

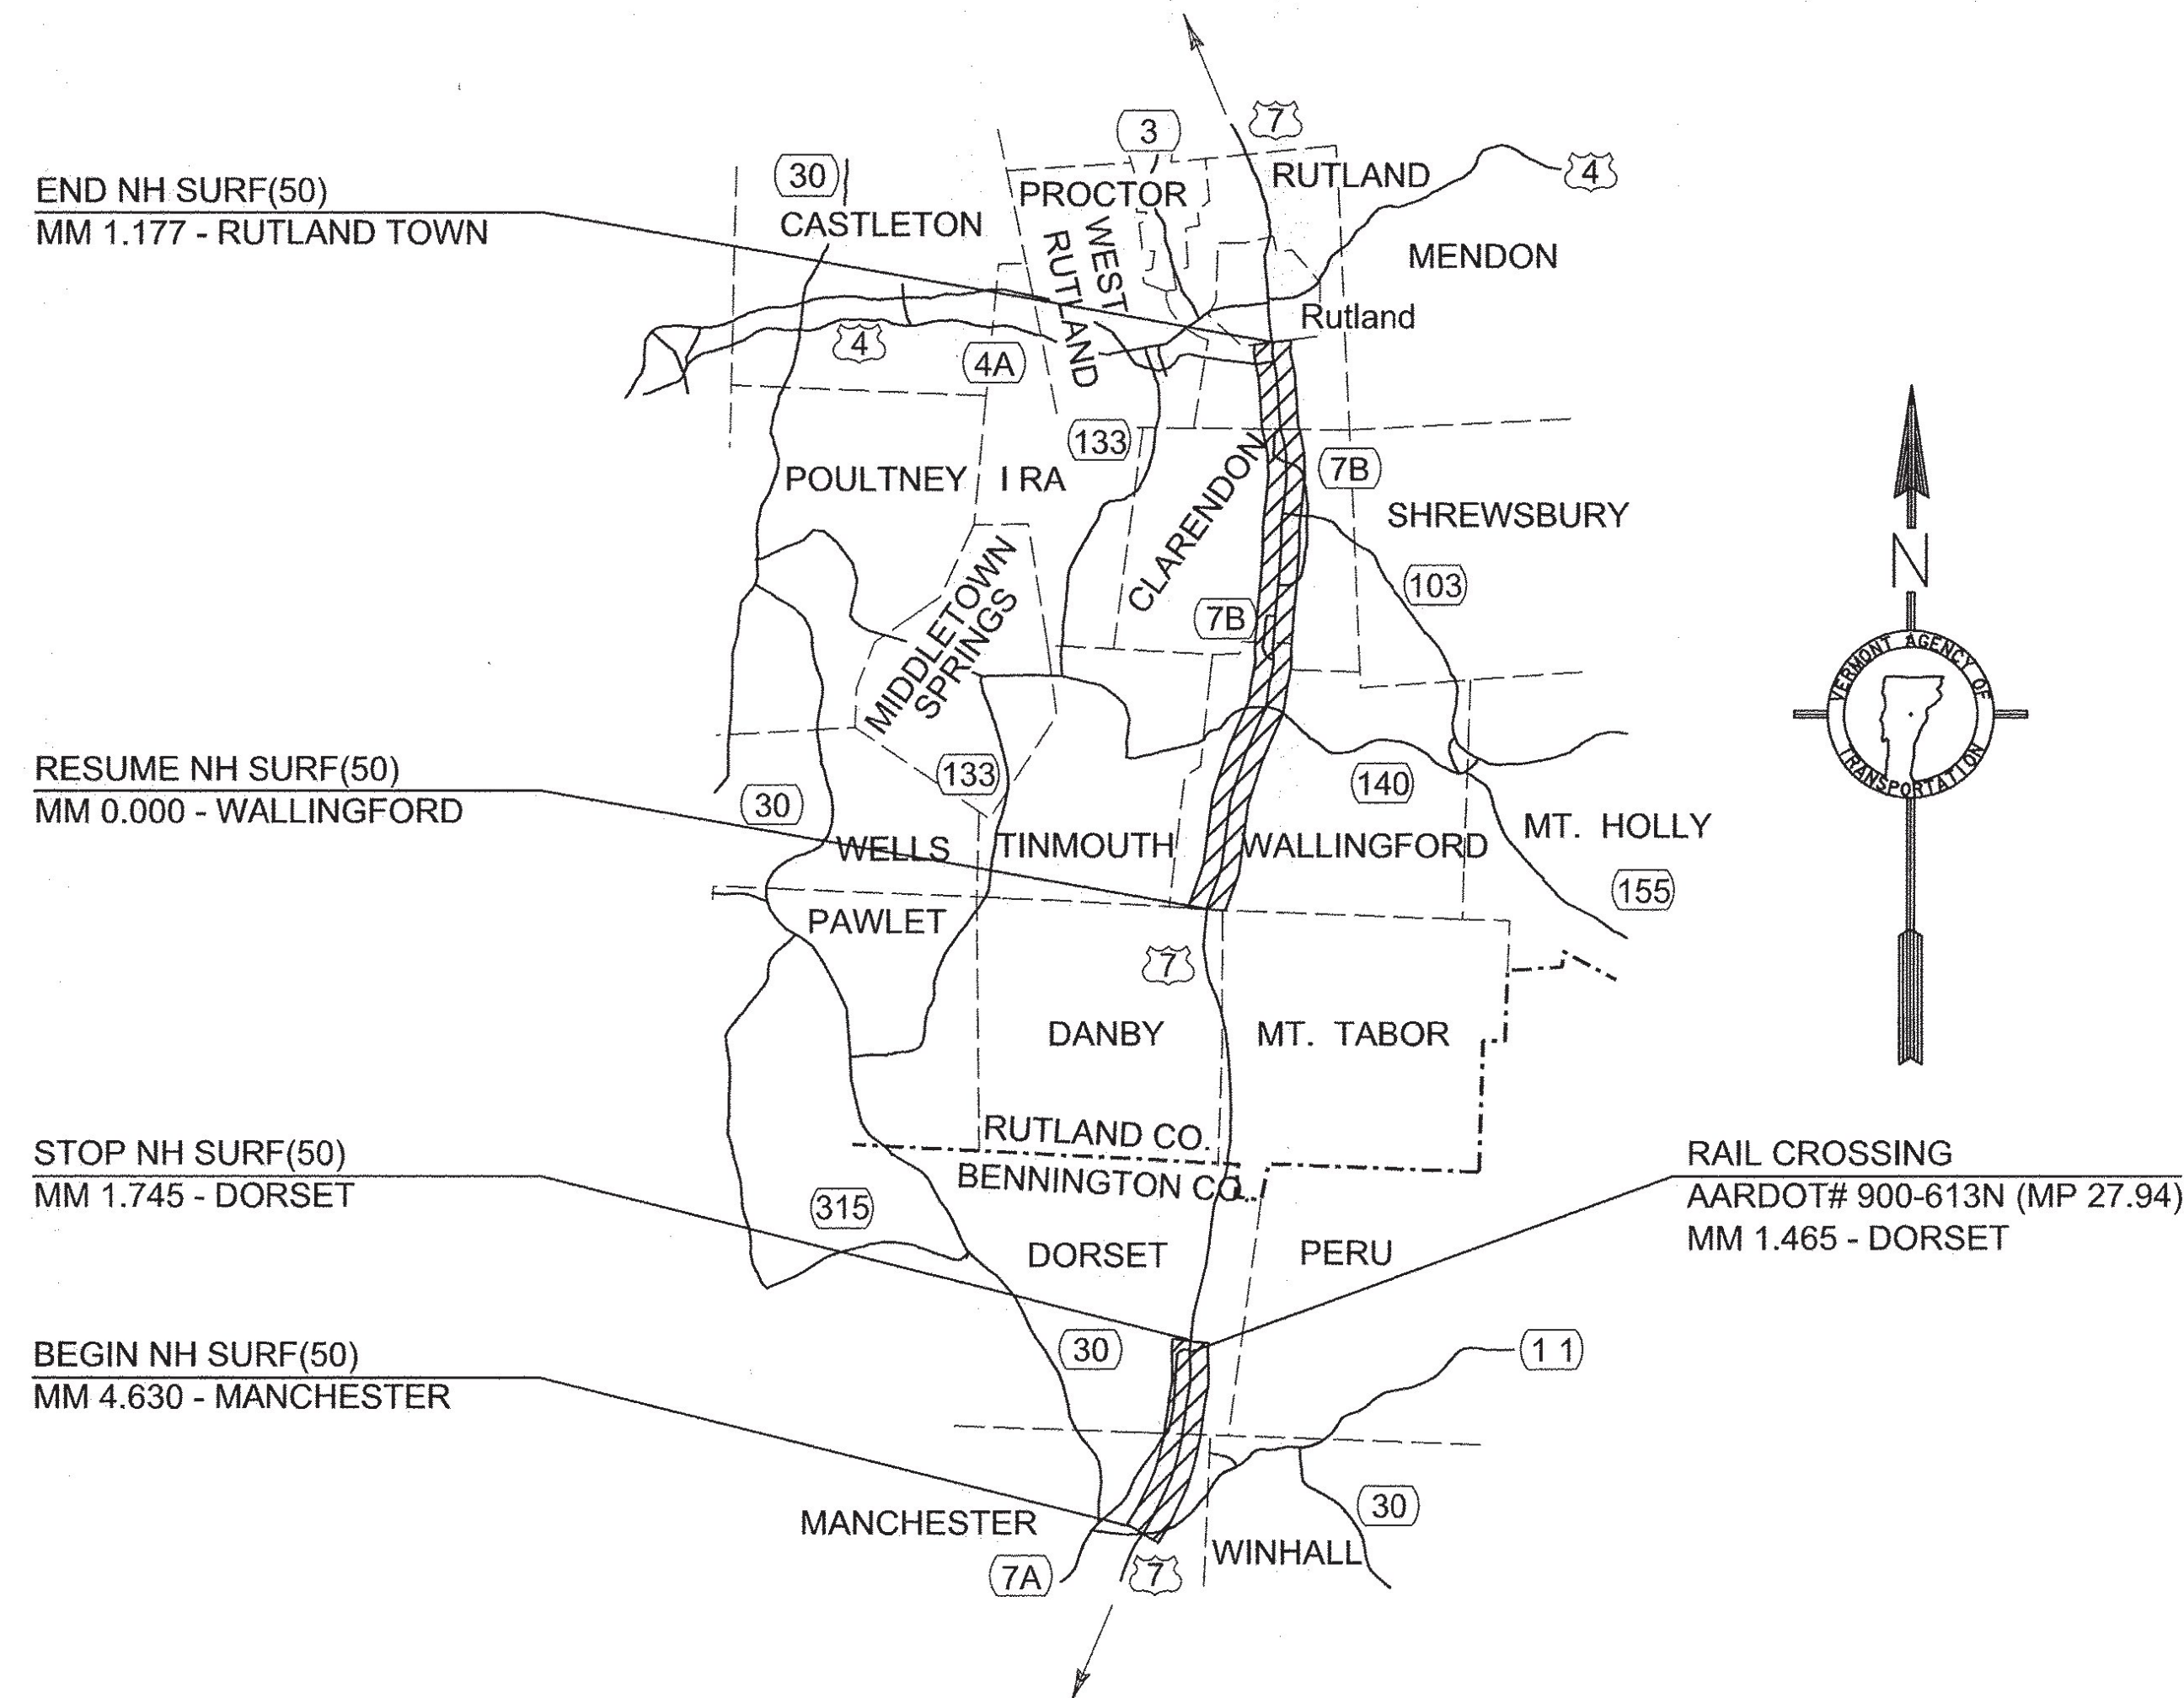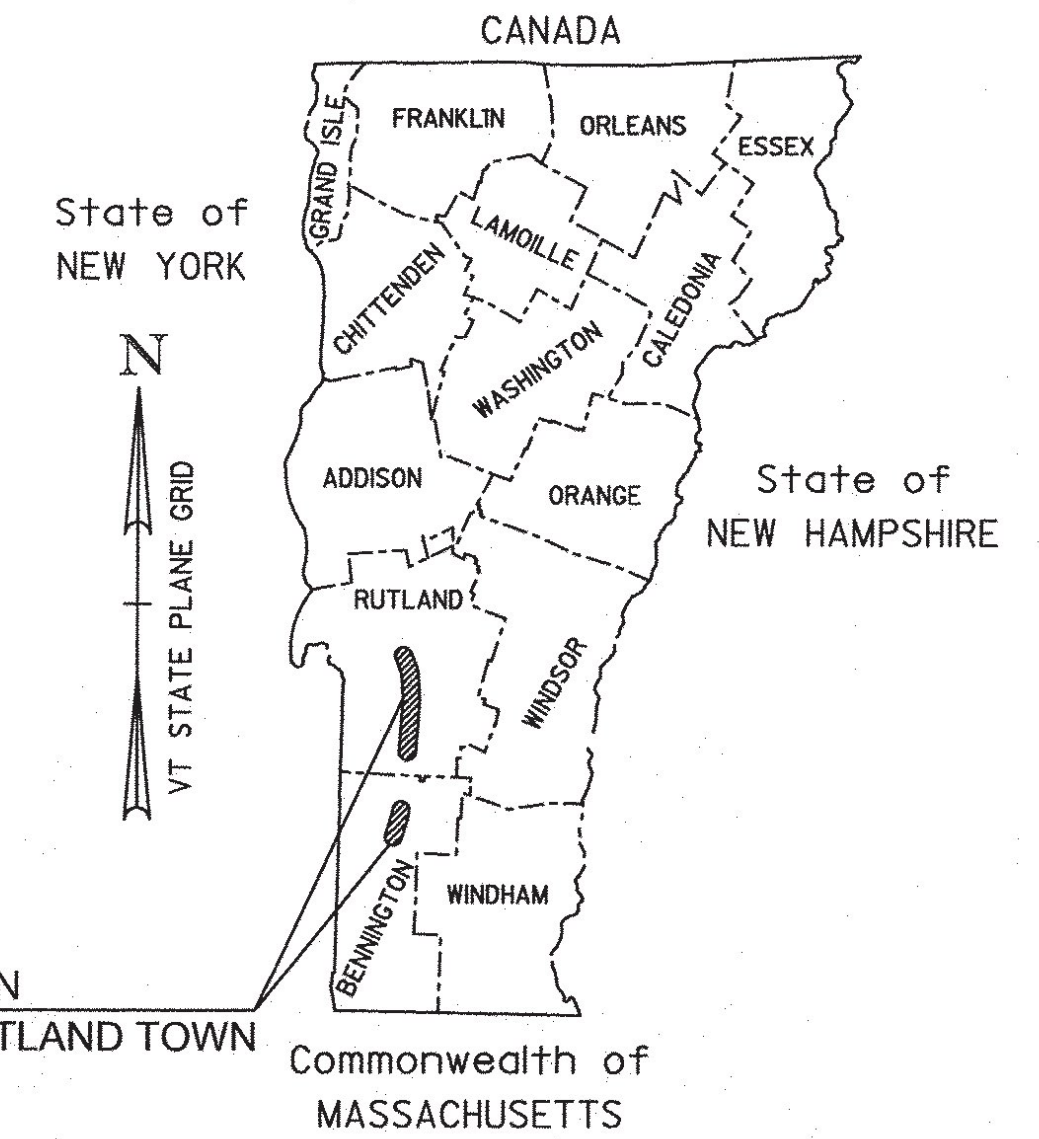

NOT TO SCALE

CONSTRUCTION IS TO BE CARRIED ON IN ACCORDANCE WITH THESE PLANS AND THE STANDARD SPECIFICATIONS FOR CONSTRUCTION DATED 2011, AS APPROVED BY THE FEDERAL HIGHWAY ADMINISTRATION ON JULY 20, 2011 FOR USE ON THIS PROJECT, INCLUDING ALL SUBSEQUENT REVISIONS AND SUCH REVISED SPECIFICATIONS AND SPECIAL PROVISIONS AS ARE INCORPORATED IN THESE PLANS.

QUALITY ASSURANCE PROGRAM : LEVEL 1	
SURVEYED BY :	NA
SURVEYED DATE :	NA
DATUM	
VERTICAL	NA
HORIZONTAL	NA

Record Plans

DIRECTOR OF PROJECT DELIVERY	
APPROVED <i>[Signature]</i>	DATE 12/22/2015
PROJECT MANAGER : MICHAEL J. FOWLER, P.E.	
PROJECT NAME : MANCHESTER - RUTLAND TOWN	
PROJECT NUMBER : NH SURF(50)	
SHEET 1 OF 105 SHEETS	