



**RECORD PLANS**

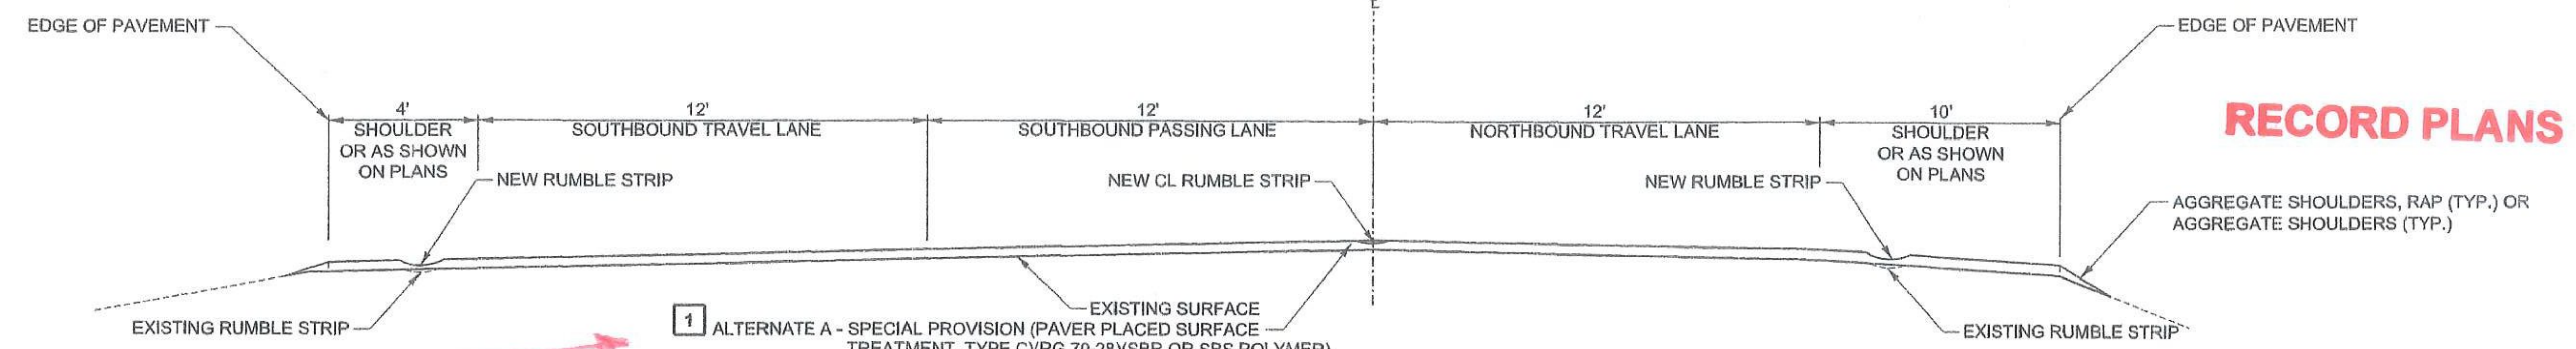

- 1 ALTERNATE A - SPECIAL PROVISION (PAVER PLACED SURFACE TREATMENT, TYPE C)(PG 70-28)(SBR OR SBS POLYMER) (3/4" +/- 1/8" LIFT THICKNESS) OR
- 1 ALTERNATE B OR C - SPECIAL PROVISION (6.3 MM POLYMER MODIFIED BITUMIN. CONC. PAVEMENT)(PG 70-28)(SBR OR SBS POLYMER) (1" +/- 1/8" LIFT THICKNESS)


**ROADWAY TYPICAL SECTION**  
NOT TO SCALE  
DORSET:  
MM 0.000 - MM 0.412  
MM 0.858 - MM 1.371

**ALTERNATE B USED**

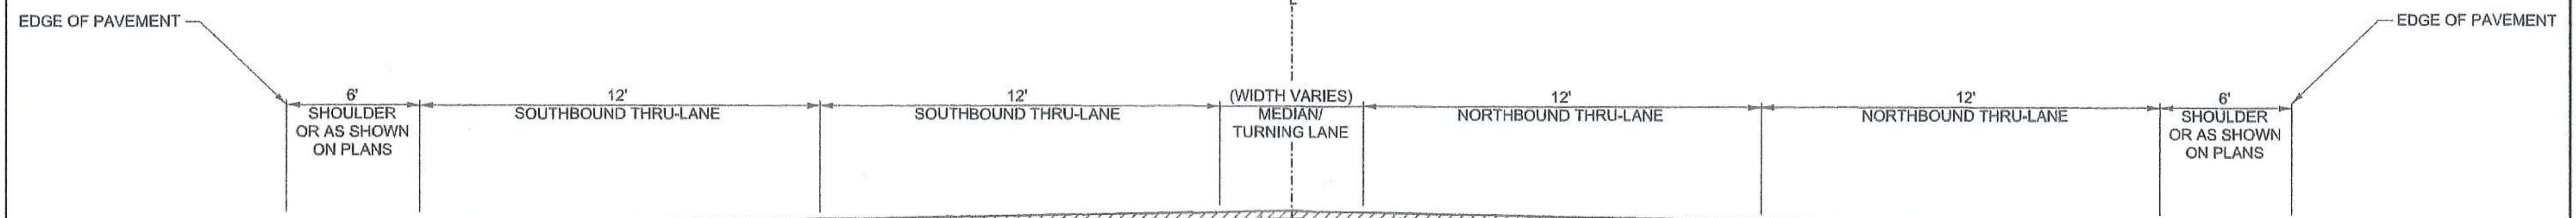

- 1 ALTERNATE A - SPECIAL PROVISION (PAVER PLACED SURFACE TREATMENT, TYPE C)(PG 70-28)(SBR OR SBS POLYMER) (3/4" +/- 1/8" LIFT THICKNESS) OR
- 1 ALTERNATE B OR C - SPECIAL PROVISION (6.3 MM POLYMER MODIFIED BITUMIN. CONC. PAVEMENT)(PG 70-28)(SBR OR SBS POLYMER) (1" +/- 1/8" LIFT THICKNESS)

**ROADWAY TYPICAL SECTION**  
NOT TO SCALE  
DORSET:  
MM 1.371 - MM 1.705 (STA 72+40 - STA 90+00)

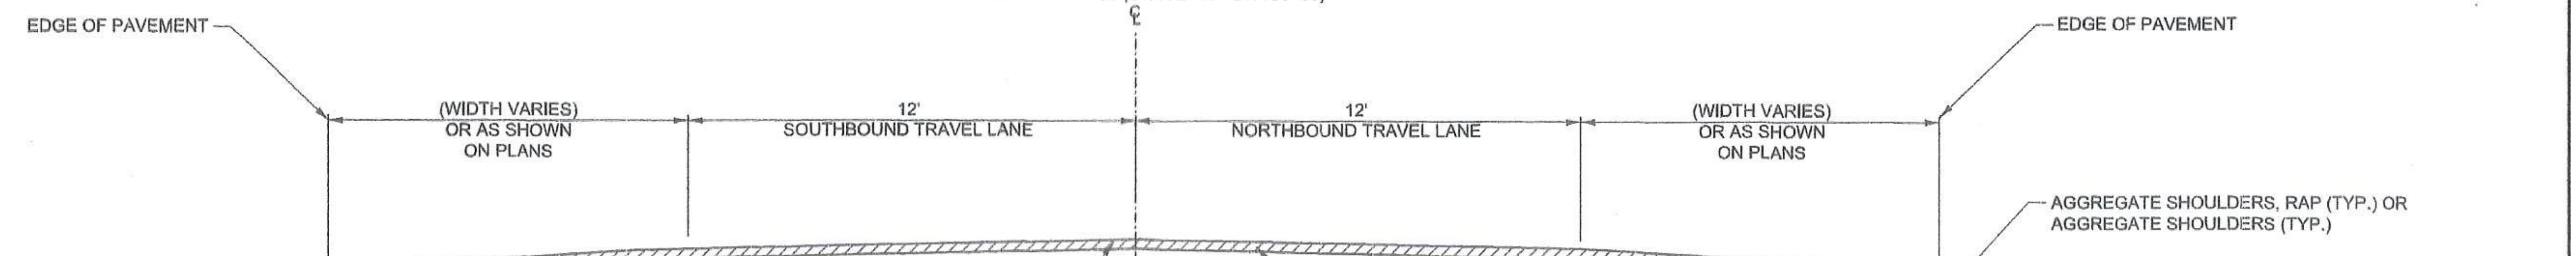

- 1 ALTERNATE A - SPECIAL PROVISION (PAVER PLACED SURFACE TREATMENT, TYPE C)(PG 70-28)(SBR OR SBS POLYMER) (3/4" +/- 1/8" LIFT THICKNESS) OR
- 1 ALTERNATE B OR C - SPECIAL PROVISION (6.3 MM POLYMER MODIFIED BITUMIN. CONC. PAVEMENT)(PG 70-28)(SBR OR SBS POLYMER) (1" +/- 1/8" LIFT THICKNESS)

**ROADWAY TYPICAL SECTION**  
NOT TO SCALE  
DORSET:  
MM 1.705 - MM 1.745 (STA 90+02 - STA 92+14)

REVISION	DATE	DESCRIPTION	BY
1	02-09-16	MODIFIED TREATMENT THICKNESSES AND TOLERANCES	BWK

PROJECT NAME:	MANCHESTER-RUTLAND TOWN
PROJECT NUMBER:	NH SURF (50)
FILE NAME:	typ02.dgn
PROJECT LEADER:	M. FOWLER
DESIGNED BY:	B. KIPP
TYPICAL SECTION SHEET 2	
PLOT DATE:	2/9/2016
DRAWN BY:	B. KIPP
CHECKED BY:	M. FOWLER
SHEET 6	OF 105