



RECORD PLANS

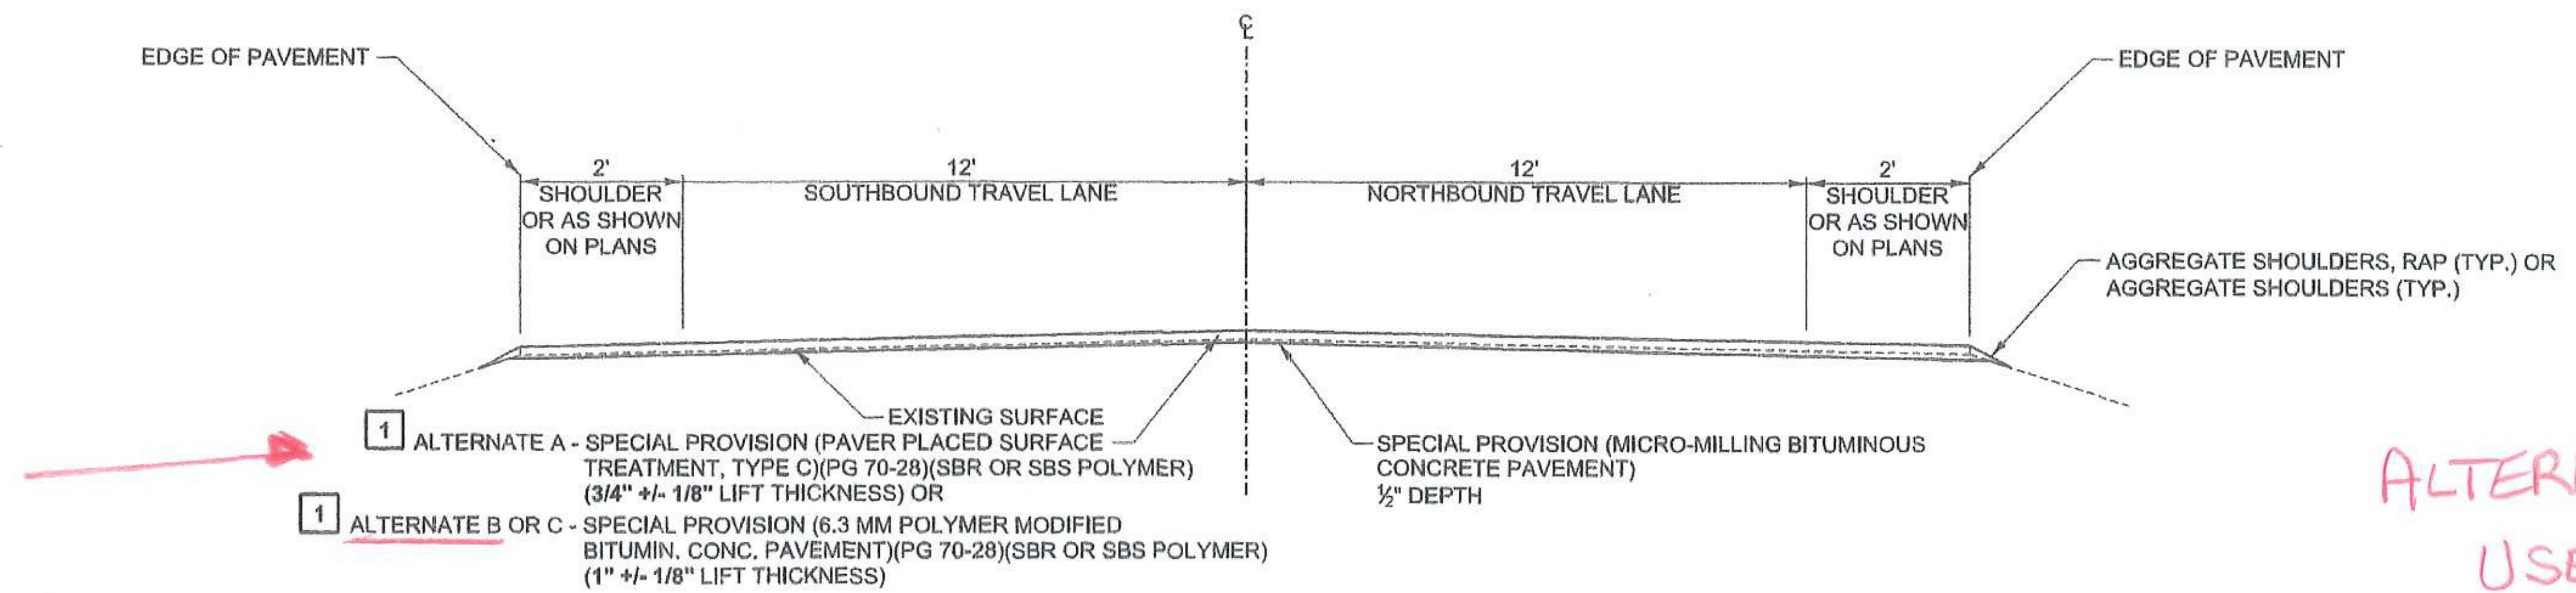

ROADWAY TYPICAL SECTION
NOT TO SCALE

WALLINGFORD:
MM 0.000 - MM 5.156 (W 0+00 - W 272+25)
MM 5.839 - MM 6.465

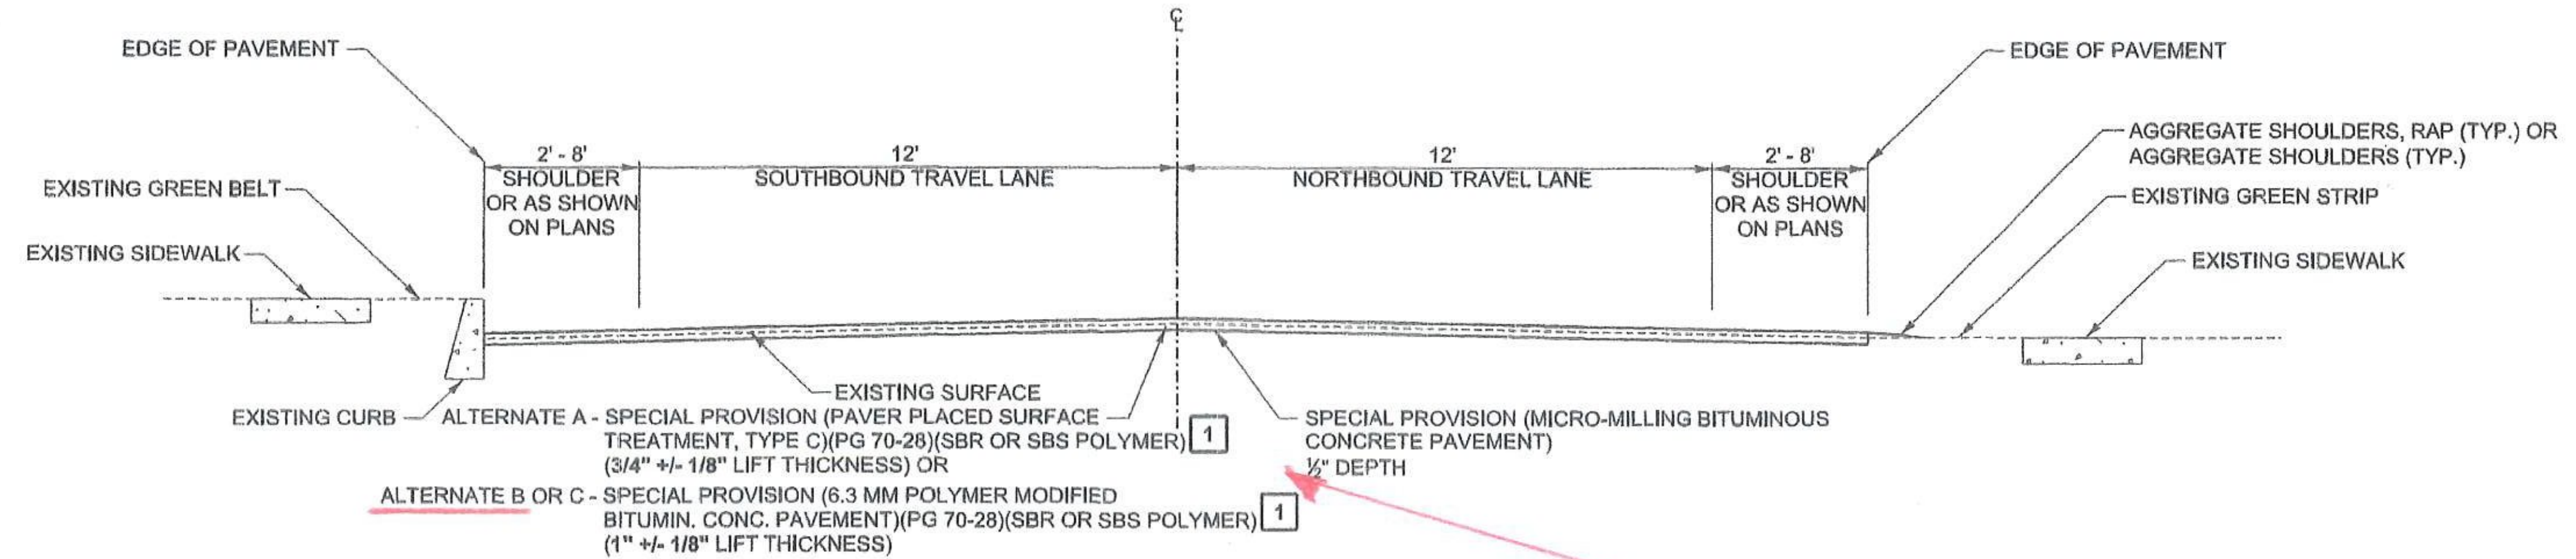

ROADWAY TYPICAL SECTION
NOT TO SCALE

WALLINGFORD:
MM 5.156 - MM 5.839 (W 272+25 - W 306+32)

REVISION	DATE	DESCRIPTION	BY
1	02-09-16	MODIFIED TREATMENT THICKNESSES AND TOLERANCES	BWK

PROJECT NAME:	MANCHESTER-RUTLAND TOWN
PROJECT NUMBER:	NH SURF (50)
FILE NAME: typ03.dgn	PLOT DATE: 2/9/2016
PROJECT LEADER: M. FOWLER	DRAWN BY: N. PAPPAS
DESIGNED BY: B. KIPP	CHECKED BY: M. FOWLER
TYPICAL SECTION SHEET 3	SHEET 7 OF 105