
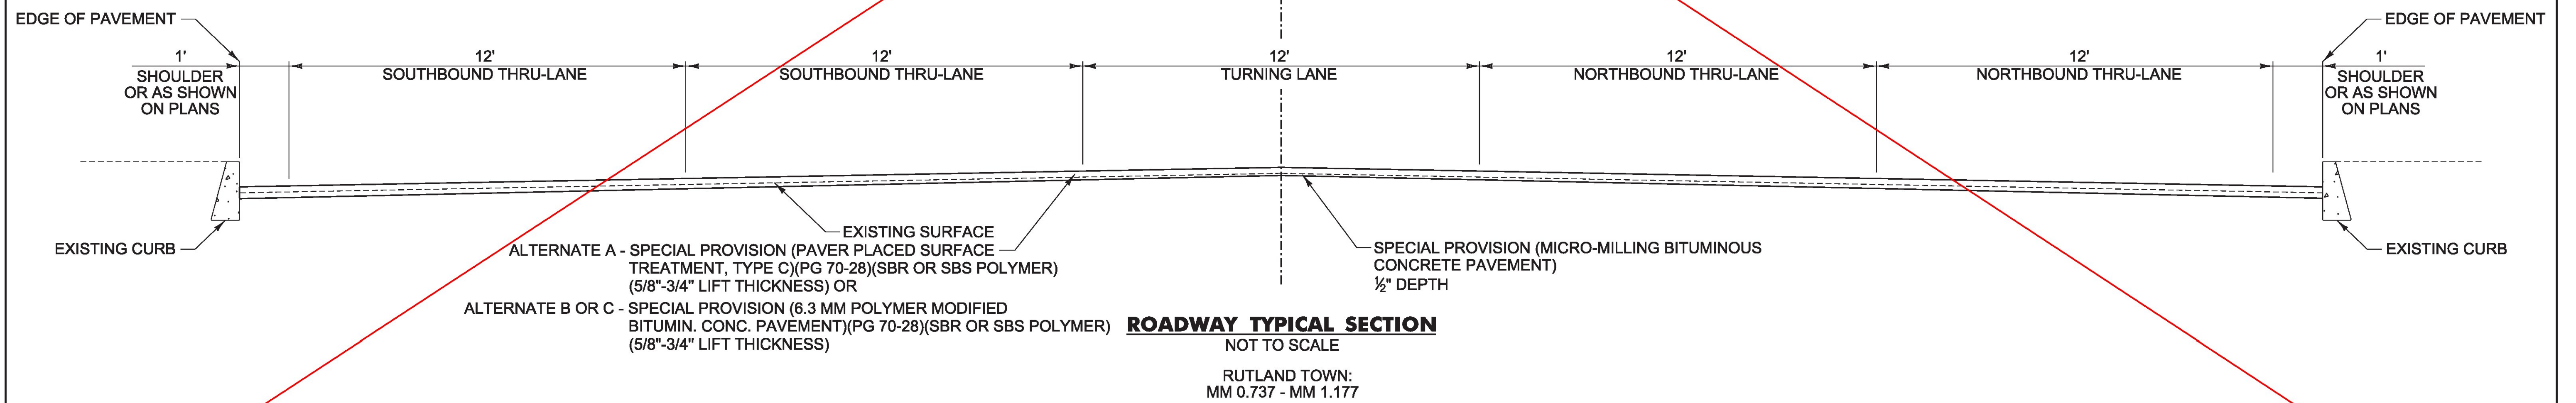
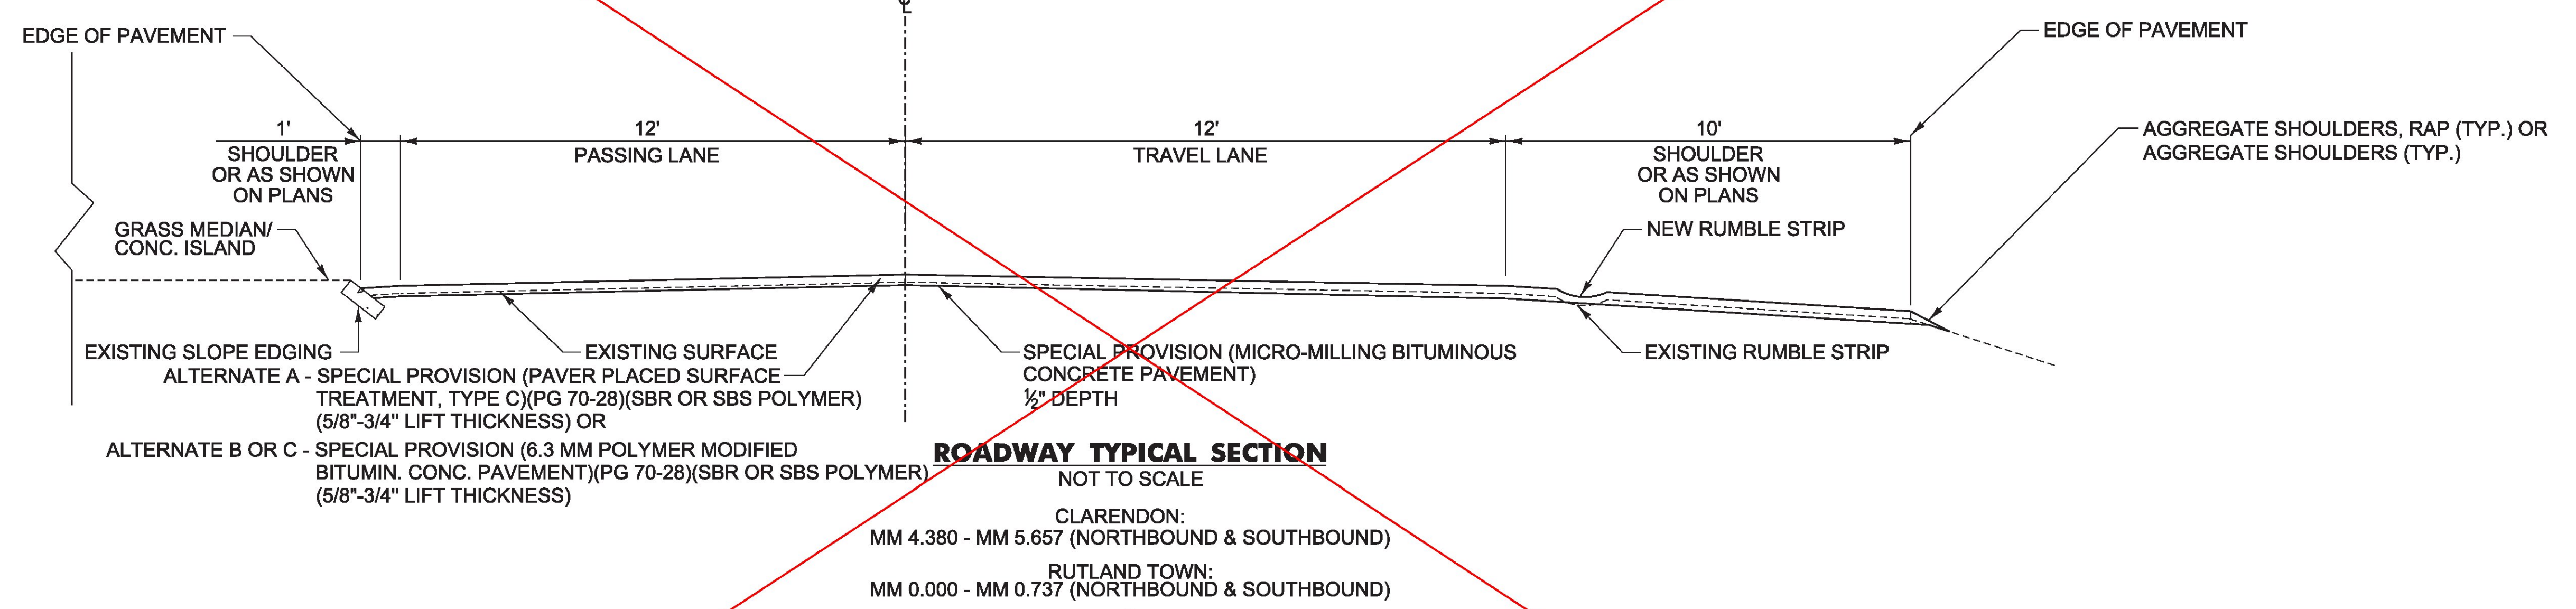


alternate B used

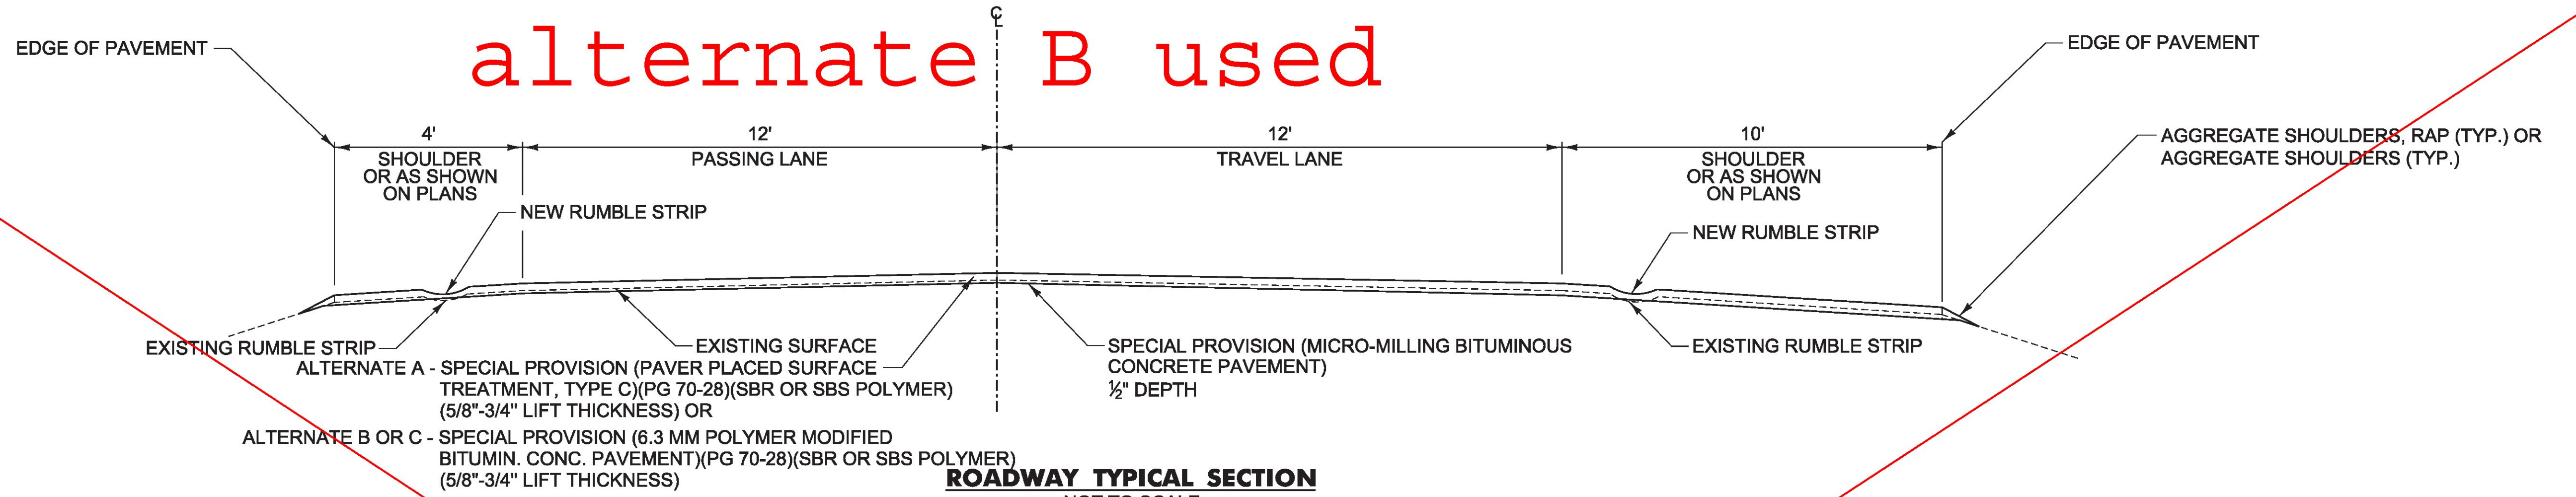

see revised sheet

PROJECT NAME:	MANCHESTER-RUTLAND TOWN
PROJECT NUMBER:	NH SURF (50)
FILE NAME: t yp04.dgn	PLOT DATE: 1/15/2016
PROJECT LEADER: M. FOWLER	DRAWN BY: N. PAPPAS
DESIGNED BY: B. KIPP	CHECKED BY: M. FOWLER
TYPICAL SECTION SHEET 4	SHEET 8 OF 105