

SPECIAL PROVISION(DURABLE 6 INCH WHITE LINE,
POLYUREA)(28 MILS)

MANCHESTER:
MM 5.133 TO MM 5.681 RT & LT
TEMPORARY 6 INCH WHITE LINE, PAINT

MANCHESTER:
MM 5.113 TO MM 5.681 RT & LT

SPECIAL PROVISION(DURABLE 6 INCH YELLOW LINE,
POLYUREA)(28 MILS)

MANCHESTER:
MM 5.113 TO MM 5.246 SOLID RT & LT
MM 5.246 TO MM 5.421 DASHED RT, SOLID LT
MM 5.421 TO MM 5.681 DASHED CL

TEMPORARY 6 INCH YELLOW LINE, PAINT


MANCHESTER:
MM 5.113 TO MM 5.246 SOLID RT & LT
MM 5.246 TO MM 5.421 DASHED RT, SOLID LT
MM 5.421 TO MM 5.681 DASHED CL

MILLED RUMBLE STRIPS (CENTERLINE)

MANCHESTER:
MM 5.133 TO MM 5.681 CL

MILLED RUMBLE STRIPS (SHOULDER)

MANCHESTER:
MM 5.133 TO MM 5.681 RT & LT

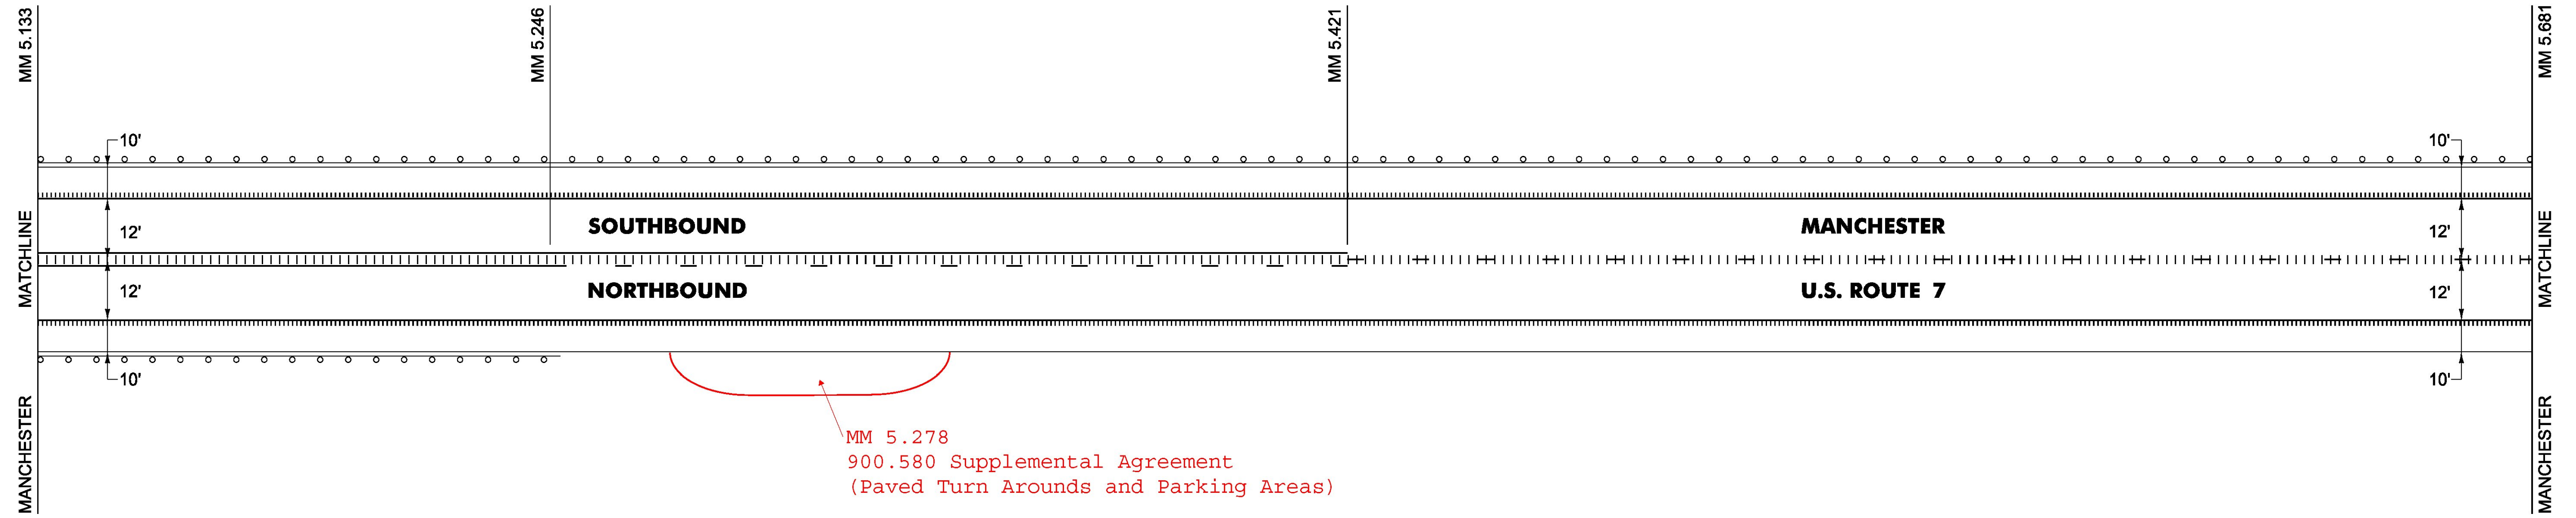

NOT TO SCALE

PROJECT NAME:	MANCHESTER-RUTLAND TOWN
PROJECT NUMBER:	NH SURF(50)
FILE NAME: layout04.dgn	PLOT DATE: 1/14/2016
PROJECT LEADER: M. FOWLER	DRAWN BY: B. KIPP
DESIGNED BY: B. KIPP	CHECKED BY: M. FOWLER
PLAN SHEET 4	SHEET 18 OF 105