

SPECIAL PROVISION(DURABLE 6 INCH WHITE LINE, POLYUREA)(28 MILS)

MANCHESTER:  
MM 6.817 TO MM 7.385 RT & LT  
MM 7.080 TO MM 7.225 DASHED RT

TEMPORARY 6 INCH WHITE LINE, PAINT

MANCHESTER:  
MM 6.817 TO MM 7.385 RT & LT  
MM 7.080 TO MM 7.225 DASHED RT

SPECIAL PROVISION(DURABLE 6 INCH YELLOW LINE, POLYUREA)(28 MILS)

MANCHESTER:  
MM 6.817 TO MM 6.916 DASHED CL  
MM 6.916 TO MM 7.027 SOLID RT, DASHED LT  
MM 7.027 TO MM 7.385 SOLID RT & LT

TEMPORARY 6 INCH YELLOW LINE, PAINT

MANCHESTER:  
MM 6.817 TO MM 6.916 DASHED CL  
MM 6.916 TO MM 7.027 SOLID RT, DASHED LT  
MM 7.027 TO MM 7.385 SOLID RT & LT

SPECIAL PROVISION(DURABLE LETTER OR SYMBOL, POLYUREA)(28 MILS)

MANCHESTER:  
MM 7.225 RT MERGE LEFT ARROW (1 EA)  
MM 7.259 RT MERGE LEFT ARROW (1 EA)  
MM 7.293 RT MERGE LEFT ARROW (1 EA)

TEMPORARY LETTER OR SYMBOL, PAINT

MANCHESTER:  
MM 7.225 RT MERGE LEFT ARROW (1 EA)  
MM 7.259 RT MERGE LEFT ARROW (1 EA)  
MM 7.293 RT MERGE LEFT ARROW (1 EA)


MILLED RUMBLE STRIPS (CENTERLINE)

MANCHESTER:  
MM 6.817 TO MM 7.385 CL

MILLED RUMBLE STRIPS (SHOULDER)

MANCHESTER:  
MM 6.817 TO MM 7.385 RT & LT

MM 7.384  
900.580 Supplemental Agreement  
(Paved Turn Arouds and Parking Areas)

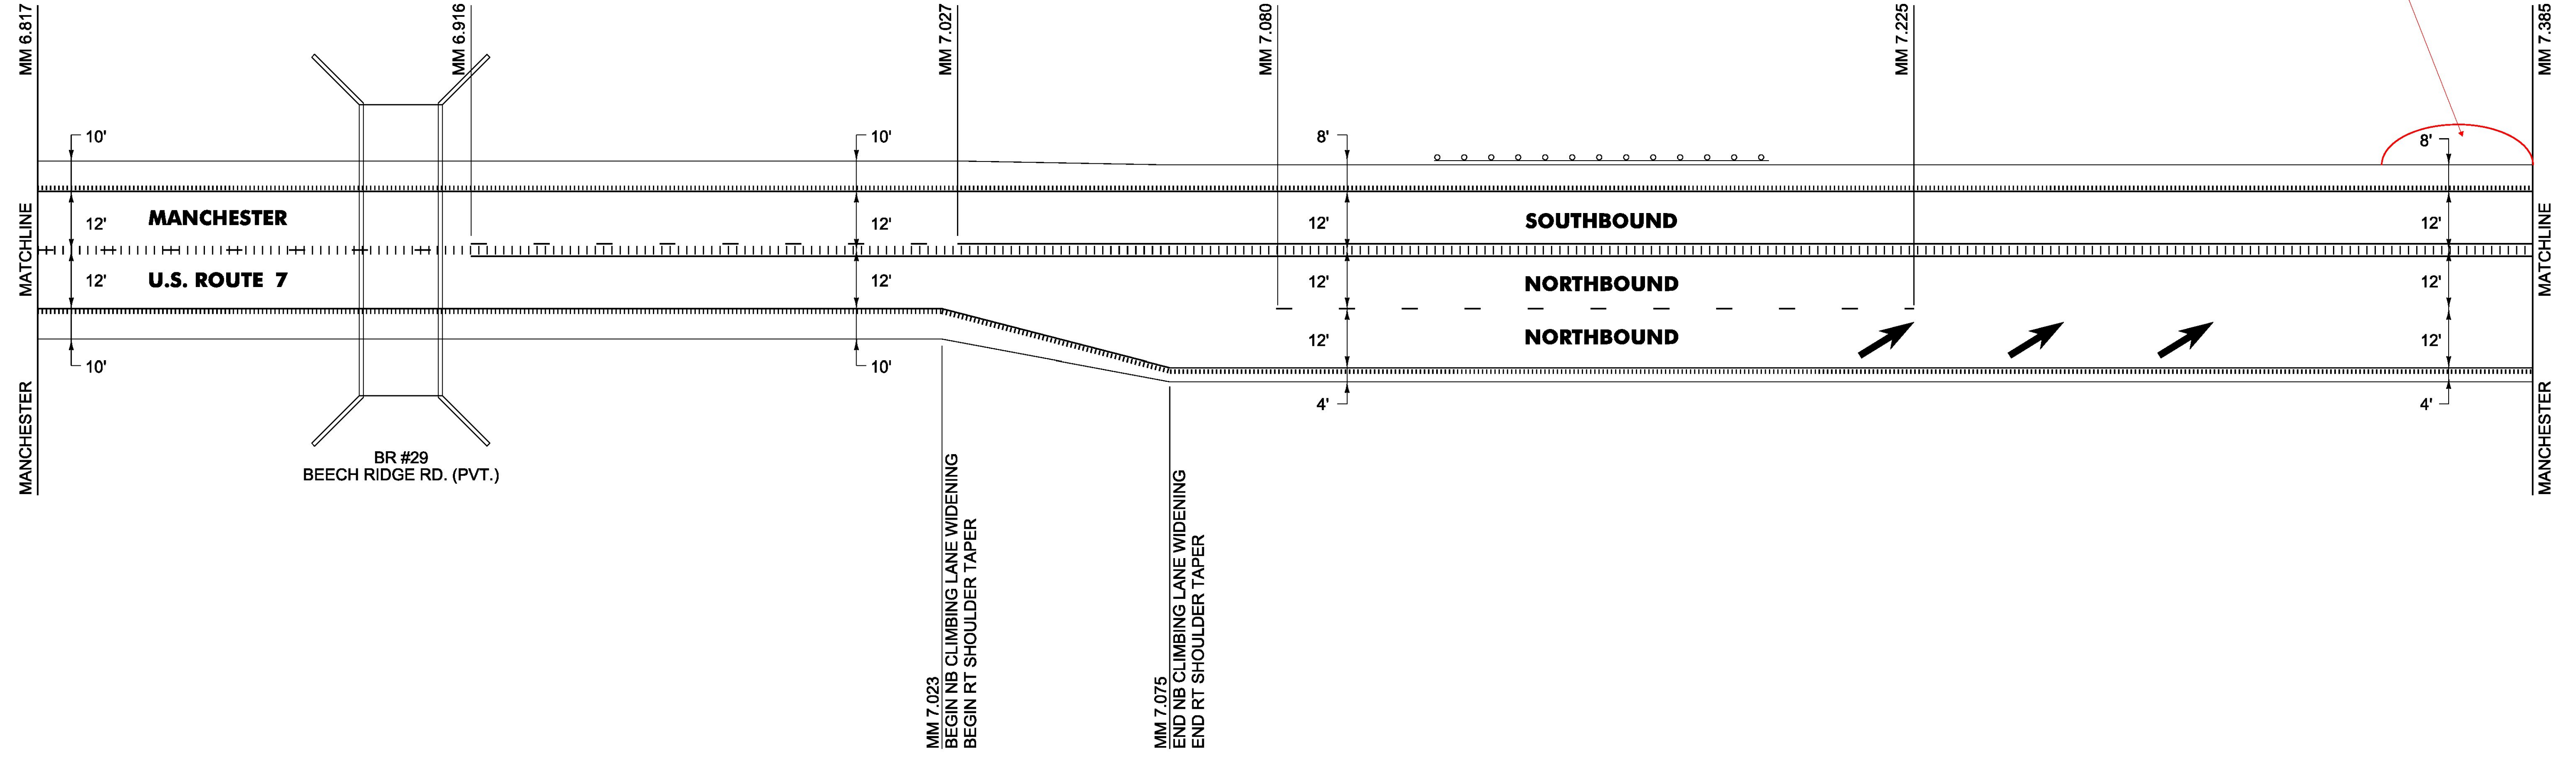

**NOT TO SCALE**

PROJECT NAME:	MANCHESTER-RUTLAND TOWN
PROJECT NUMBER:	NH SURF(50)
FILE NAME:	layout07.dgn
PROJECT LEADER:	M. FOWLER
DESIGNED BY:	B. KIPP
PLAN SHEET	7
PLOT DATE:	1/14/2016
DRAWN BY:	B. KIPP
CHECKED BY:	M. FOWLER
SHEET	21 OF 105