

SPECIAL PROVISION(DURABLE 6 INCH WHITE LINE, POLYUREA)(28 MILS)

DORSET:
MM 1.001 TO MM 1.569 RT & LT
MM 1.044 TO MM 1.569 DASHED LT

TEMPORARY 6 INCH WHITE LINE, PAINT

DORSET:
MM 1.001 TO MM 1.569 RT & LT
MM 1.044 TO MM 1.569 DASHED LT

SPECIAL PROVISION(DURABLE 6 INCH YELLOW LINE, POLYUREA)(28 MILS)

DORSET:
MM 1.001 TO MM 1.569 SOLID RT & LT

TEMPORARY 6 INCH YELLOW LINE, PAINT

DORSET:
MM 1.001 TO MM 1.569 SOLID RT & LT

SPECIAL PROVISION(DURABLE LETTER OR SYMBOL, POLYUREA)(28 MILS)

DORSET:
MM 1.015 LT MERGE LEFT ARROW (1 EA)
MM 1.049 LT MERGE LEFT ARROW (1 EA)

TEMPORARY LETTER OR SYMBOL, PAINT

DORSET:
MM 1.015 LT MERGE LEFT ARROW (1 EA)
MM 1.049 LT MERGE LEFT ARROW (1 EA)

SPECIAL PROVISION(DURABLE RAILROAD CROSSING SYMBOL, POLYUREA)(28 MILS)

DORSET:
MM 1.320 RT

TEMPORARY RAILROAD CROSSING SYMBOL, PAINT


DORSET:
MM 1.320 RT

MILLED RUMBLE STRIPS (CENTERLINE)

DORSET:
MM 1.001 TO MM 1.285 CL

MILLED RUMBLE STRIPS (SHOULDER)

DORSET:
MM 1.001 TO MM 1.285 RT & LT

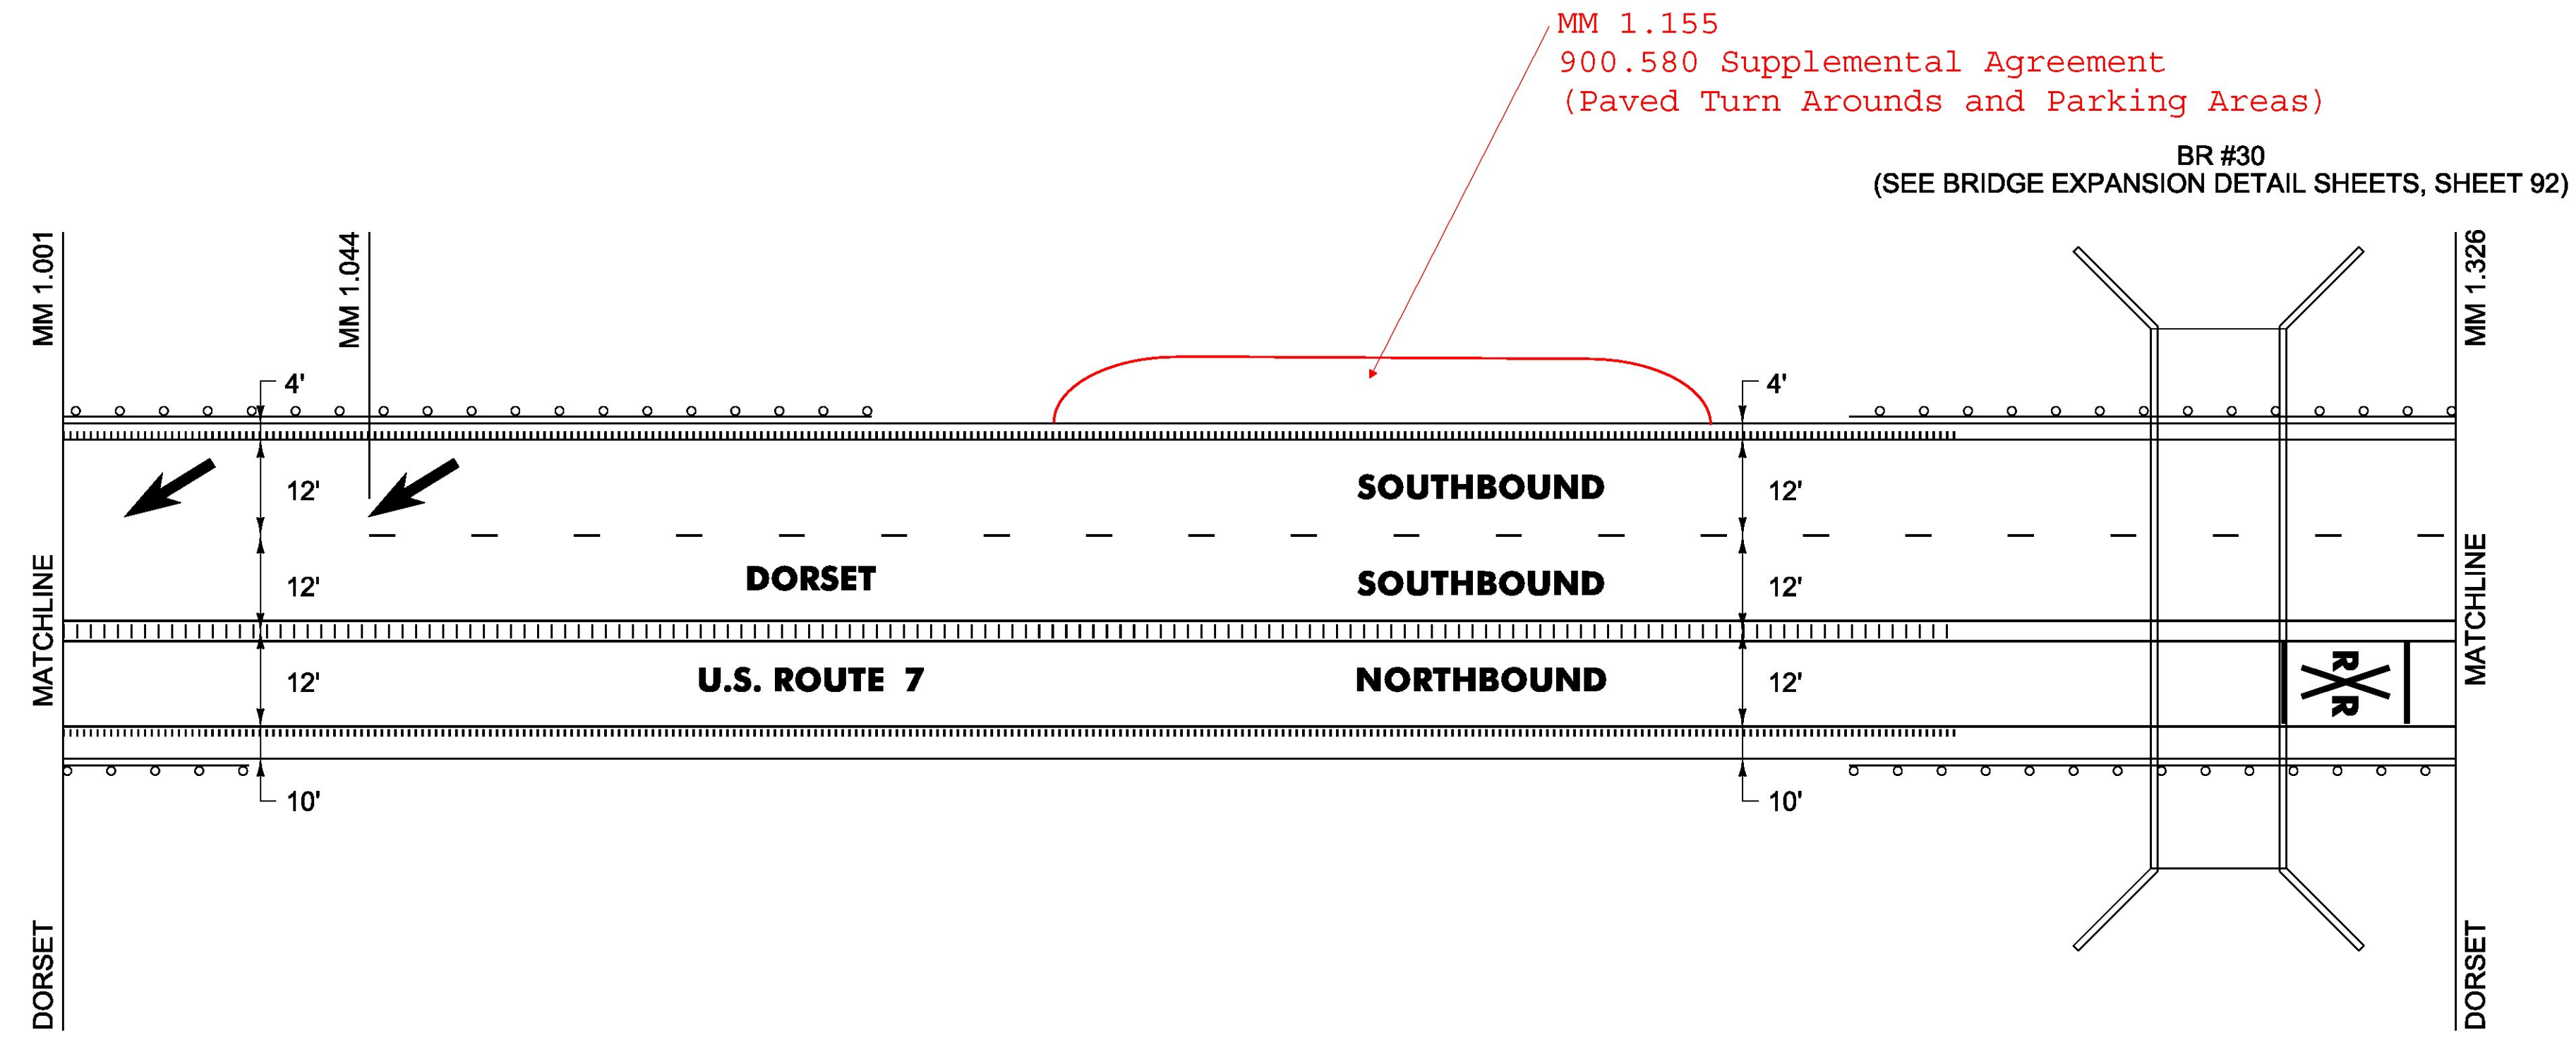

NOT TO SCALE

PROJECT NAME:	MANCHESTER-RUTLAND TOWN
PROJECT NUMBER:	NH SURF(50)
FILE NAME:	layout10.dgn
PROJECT LEADER:	M. FOWLER
DESIGNED BY:	B. KIPP
PLAN SHEET 10	
PLOT DATE:	1/14/2016
DRAWN BY:	B. KIPP
CHECKED BY:	M. FOWLER
SHEET 24	OF 105