

SPECIAL PROVISION(DURABLE 6 INCH WHITE LINE, POLYUREA)(28 MILS)

US ROUTE 7:
85+00 TO 92+14 SOLID RT & LT
88+53 TO 92+14 DOTTED LANE LINE LT

TEMPORARY 6 INCH WHITE LINE, PAINT

US ROUTE 7:
85+00 TO 92+14 SOLID RT & LT
88+53 TO 92+14 DOTTED LANE LINE LT

SPECIAL PROVISION(DURABLE 6 INCH YELLOW LINE, POLYUREA)(28 MILS)

US ROUTE 7:
85+00 TO 86+25 DOUBLE SOLID MEDIAN RT & LT
85+00 TO 86+50 SOLID LT, VT ROUTE 7A
86+25 TO 90+20 SOLID RT & LT
90+60 TO 92+14 SOLID RT & LT
90+39 DOUBLE SOLID RT, TH 5

TEMPORARY 6 INCH YELLOW LINE, PAINT

US ROUTE 7:
85+00 TO 86+25 DOUBLE SOLID MEDIAN RT & LT
85+00 TO 86+50 SOLID LT, VT ROUTE 7A
86+25 TO 90+20 SOLID RT & LT
90+60 TO 92+14 SOLID RT & LT
90+39 DOUBLE SOLID RT, TH 5

SPECIAL PROVISION(DURABLE 12 INCH WHITE LINE, POLYUREA)(28 MILS)

US ROUTE 7:
86+25 TO 88+53 GORE AREA LT

SPECIAL PROVISION(DURABLE 24 INCH STOP BAR, POLYUREA)(28 MILS)

US ROUTE 7:
90+39 RT, TH 5

TEMPORARY 24 INCH STOP BAR, PAINT

US ROUTE 7:
90+39 RT, TH 5

SPECIAL PROVISION(DURABLE 12 INCH YELLOW LINE, POLYUREA)(28 MILS)


US ROUTE 7:
85+00 TO 86+25 HATCHED MEDIAN RT

SPECIAL PROVISION(DURABLE LETTER OR SYMBOL, POLYUREA)(28 MILS)

US ROUTE 7:
86+60 RT MERGE ARROW (1 EA)
90+39 RT, TH 5 - "S,T,O,P" (4 EA)

TEMPORARY LETTER OR SYMBOL, PAINT

US ROUTE 7:
86+60 RT MERGE ARROW (1 EA)
90+39 RT, TH 5 - "S,T,O,P" (4 EA)

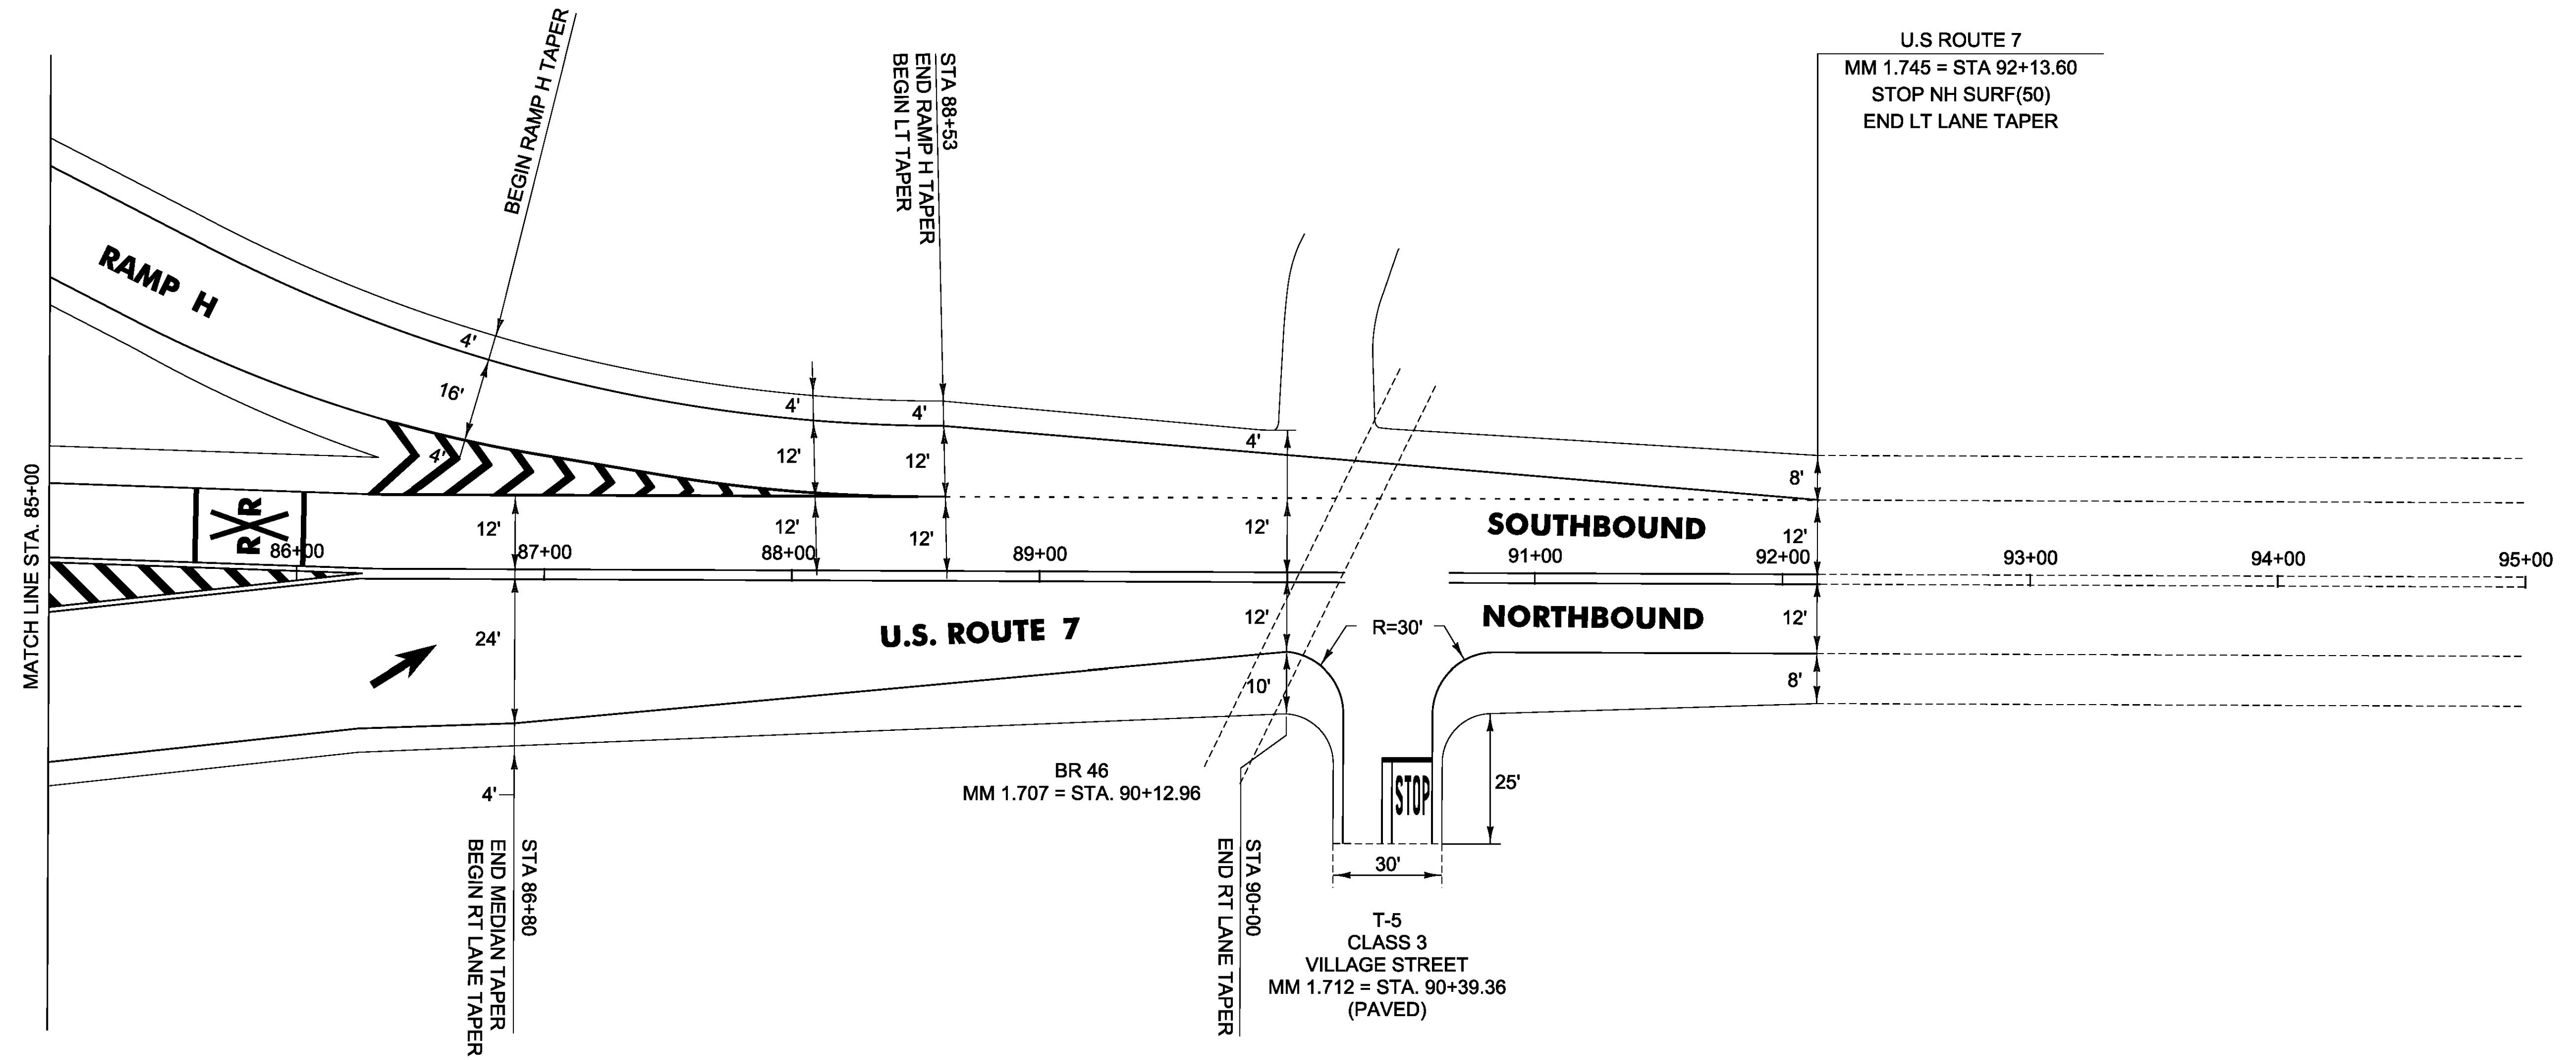

U.S ROUTE 7
MM 1.745 = STA 92+13.60
STOP NH SURF(50)
END LT LANE TAPER

DURABLE RAILROAD CROSSING SYMBOL, POLYUREA

US ROUTE 7:
85+90 LT (1 EA)

TEMPORARY RAILROAD CROSSING SYMBOL, PAINT

US ROUTE 7:
85+90 LT (1 EA)

PROJECT NAME:	MANCHESTER-RUTLAND TOWN
PROJECT NUMBER:	NH SURF(50)
FILE NAME: layout13.dgn	PLOT DATE: 1/14/2016
PROJECT LEADER: M. FOWLER	DRAWN BY: B. KIPP
DESIGNED BY: B. KIPP	CHECKED BY: M. FOWLER
PLAN SHEET 13	SHEET 27 OF 105