



SPECIAL PROVISION(DURABLE 4 INCH WHITE LINE, POLYUREA)(28 MILS)
 W 0+00 TO W 11+00 SOLID LT & RT

TEMPORARY 4 INCH WHITE LINE, PAINT
 W 0+00 TO W 11+00 SOLID LT & RT

SPECIAL PROVISION(DURABLE 4 INCH YELLOW LINE, POLYUREA)(28 MILS)
 W 0+00 TO W 7+40 DASHED LT, SOLID RT
 W 7+40 TO W 11+00 SOLID LT & RT

TEMPORARY 4 INCH YELLOW LINE, PAINT
 W 0+00 TO W 7+40 DASHED LT, SOLID RT
 W 7+40 TO W 11+00 SOLID LT & RT

MILLED RUMBLE STRIPS (CENTERLINE)
 W 9+00 TO W 11+00 CL

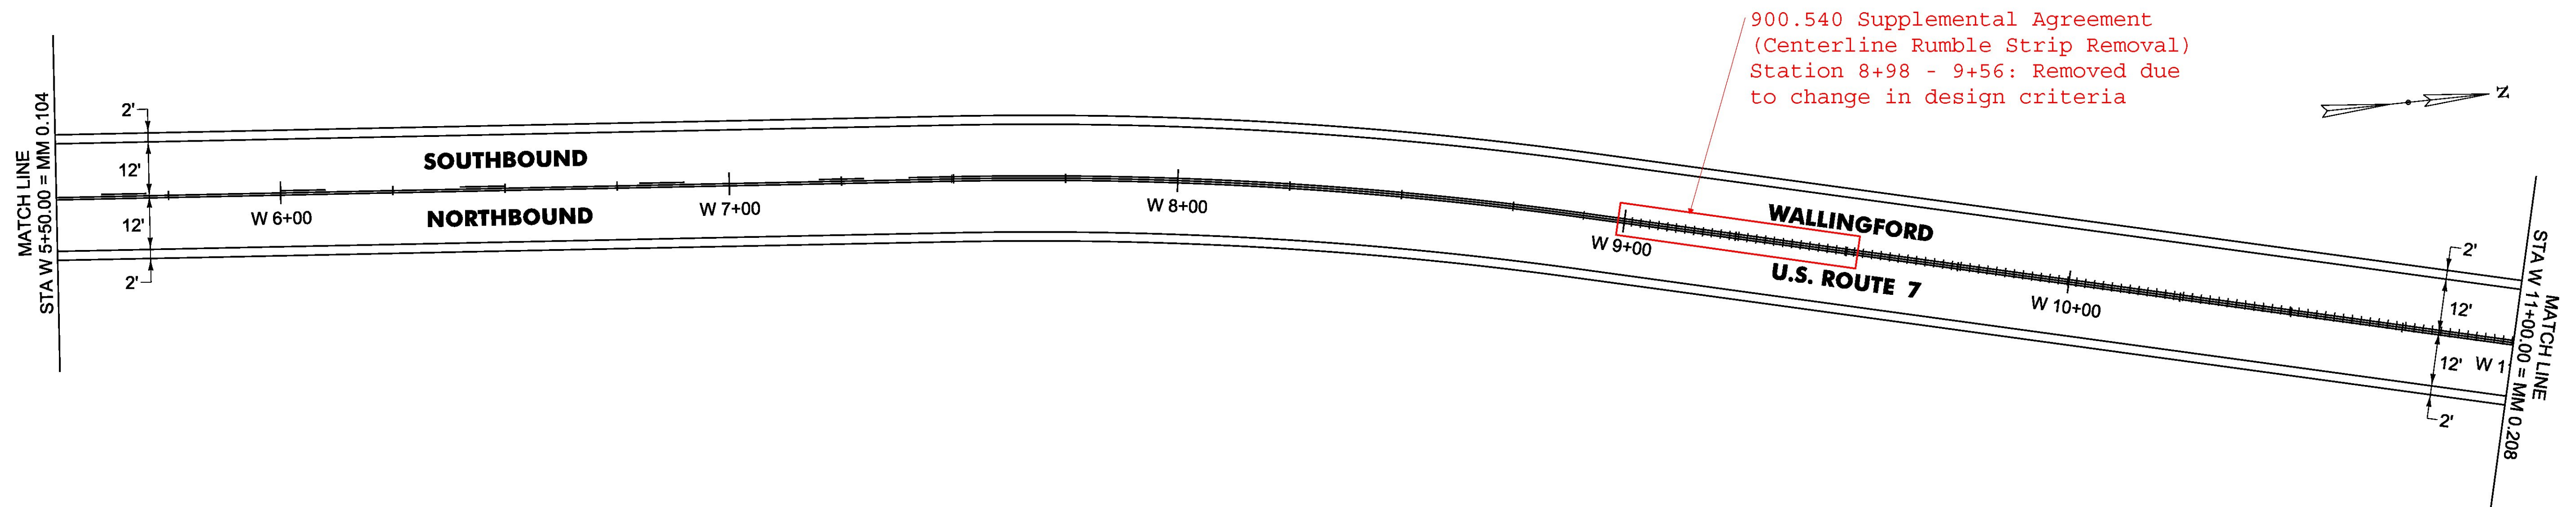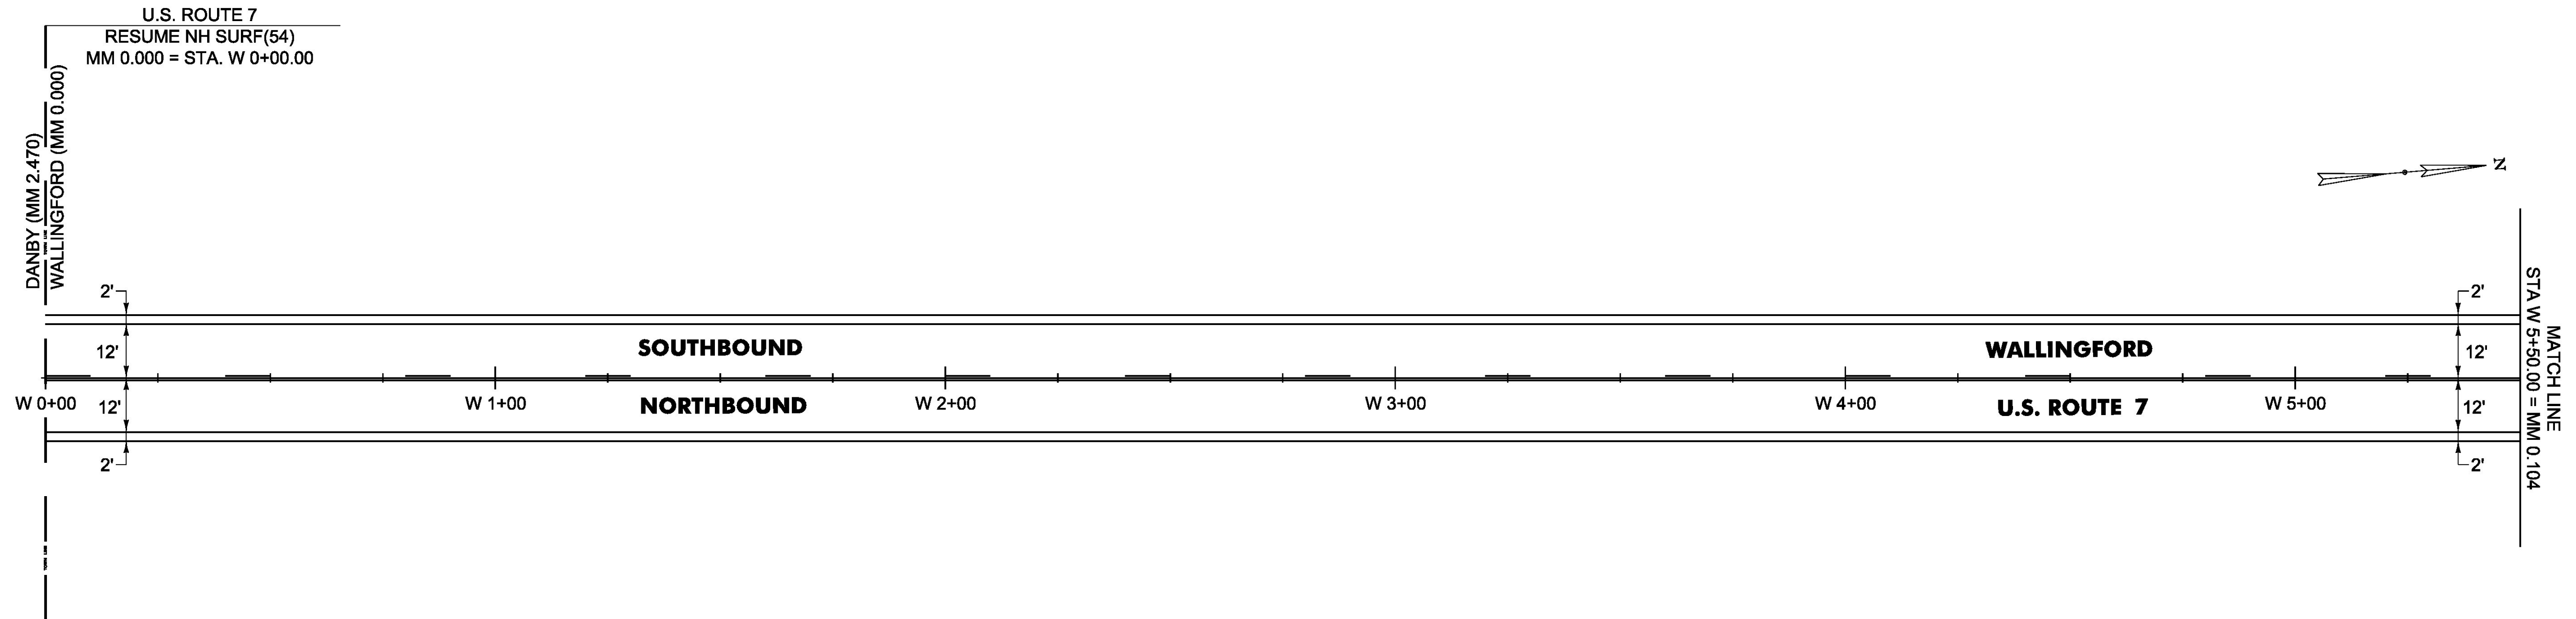

NOT TO SCALE

PROJECT NAME:	MANCHESTER-RUTLAND TOWN
PROJECT NUMBER:	NH SURF(50)
FILE NAME:	layout14.dgn
PROJECT LEADER:	M. FOWLER
DESIGNED BY:	B. KIPP
PLAN SHEET 14	
PLOT DATE:	1/14/2016
DRAWN BY:	B. KIPP
CHECKED BY:	M. FOWLER
SHEET 28	OF 105